GENERAL:

- LOCATE, CUT AND FRAME ROOF OPENINGS AS SHOWN FOR ALL HVAC EQUIPMENT AND EXHAUST FANS.
- 2. IT IS VERY IMPORTANT THAT ACCURATE MEASUREMENTS ARE USED WHEN LOCATING EXHAUST FAN ROOF OPENINGS TO ENSURE THAT NO ADDITIONAL OFFSETS ARE REQUIRED IN THE EXHAUST DUCTWORK. COORDINATE ROOF OPENINGS WITH THE KITCHEN EQUIPMENT.
- 3. PROVIDE ANY FRAMING REQUIRED FOR DIFFUSER INSTALLATION IN HARD CEILING.

HVAC:

- I. INSTALLATION SHALL CONFORM TO THE ENERGY CONSERVATION DESIGN MANUAL STANDARDS FOR NEW NONRESIDENTIAL BUILDINGS, IF REQUIRED.
- 2. ALL WORK AND MATERIALS SHALL COMPLY WITH GOVERNING CODES, SAFETY ORDERS AND REGULATIONS.
- 3. OBTAIN AND PAY FOR ALL NECESSARY PERMITS, FEES AND INSPECTIONS REQUIRED BY GOVERNING AUTHORITIES.
- 4. COORDINATE WITH ELECTRICAL CONTRACTOR TO PROVIDE CONDUIT FOR LINE AND LOW VOLTAGE WIRING, LINE VOLTAGE WIRING SWITCHES, AND FINAL CONNECTIONS.
- ANY EQUIPMENT THAT IS SUBSTITUTED SHALL FIT IN THE SPACE PROVIDED WITH ADEQUATE ROOM FOR SERVICING, INCLUDING SUBSTITUTE EQUIPMENT NAMED IN THE SPECIFICATIONS. SUBMIT A 1/4" SCALE DRAWING OF ALL EQUIPMENT SUBSTITUTED FOR APPROVAL PRIOR TO INSTALLATION, INCLUDING, BUT NOT LIMITED TO, STRUCTURAL AND ARCHITECTURAL IMPACT, CLEARANCE REQUIREMENTS AND UTILITY REQUIREMENTS.
- $_{5.}$ FOR INSTALLATION OF RECHARGEABLE REFRIGERANT LINES FROM ICE MACHINE TO CONDENSER ON ROOF, SEE SCOPE OF WORK.
- 7. HVAC UNITS SHALL BE MOUNTED LEVEL ON ROOF CURBS.
- 8. ALL DUCTWORK SHALL BE EXTERNALLY INSULATED.
- 9. ALL SUPPLY / RETURN DUCTS SHALL BE RIGID, WITH THE EXCEPTION OF THE LAST 10'-0" WHICH MAY BE FLEX.
- ^^^^^^^^^^^^^^^^^^^^^^ 10. SMOKE DETECTOR SHALL BE INSTALLED IN THE SUPPLY AIR DUCT AND SHALL DEACTIVATE ROOFTOP UNIT UPON SENSING SMOKE. SMOKE DETECTOR SHALL BE INSTALLED, PRIOR TO ANY OUTSIDE AIR CONNECTIONS.
- 11. ALL HOOD EXHAUST DUCTS SHALL BE RIGID 16 GA MINIMUM, WELDED DUCT. GRIND ALL WELDS SMOOTH. PROVIDE FIRE MASTER DUCT WRAP FOR ALL HOOD EXHAUST DUCTS. SEE 15/M4.0.
- 12. ALL BRANCH DUCTS FEEDING INDIVIDUAL DIFFUSERS SHALL HAVE DAMPERS AT TAKEOFFS FOR AIR BALANCING. PROVIDE ACCESS PANELS TO DAMPERS. SEE 8 / M4.0
- 13. ALL UTILITY PIPING FOR RTU'S SHALL RUN UP THROUGH ROOF INSIDE EACH UNIT'S ROOF CURB.
- 14. ALL OUTSIDE AIR INTAKES SHALL BE A MINIMUM OF 10'-0" FROM EXHAUST FANS AND / OR VENTS.

SUPPLY AIR (RISE/DROP)

RETURN AIR DUCT (RISE/DROP)

EXHAUST AIR DUCT (RISE/DROP)

RETURN REGISTER/GRILLE

EXHAUST REGISTER/GRILLE

FLEXIBLE CONNECTION

FIRE DAMPER

MANUAL VOLUME DAMPER

CEILING DIFFUSER/SUPPLY REGISTER

(ARROWHEAD REPRESENTS NUMBER OF THROW)

RECTANGULAR DUCT ELBOW WITH TURNING VANES

DUCT LINING (1" THICK UNLESS OTHERWISE NOTED)

DUCT TRANSITION (RECTANGULAR TO ROUND)

THERMOSTAT: SEE GENERAL NOTE 17, THIS SHEET

THERMOSTAT SENSOR (REMOTE): SEE GENERAL NOTE 18, THIS SHEET

SINGLE LINE DUCT BRANCH TAKEOFF

FLEXIBLE DUCT (14'-0 MAXIMUM)

MECHANICAL EQUIPMENT DESIGNATION

SMOKE DETECTOR; SEE GENERAL NOTE 10, THIS SHEET.

CONDENSATE DRAIN

DIAMETER

DOOR LOUVER

DOOR UNDERCUT

AIR CONDITIONING

BACK DRAFT DAMPER

15. SEE 8 / M1.0 AND SCOPE OF WORK FOR DESCRIPTION OF HVAC PACKAGE TO BE PURCHASED THROUGH YUM! BRANDS NATIONAL CONTRACT.

DESCRIPTION

- 16. FINAL HVAC SYSTEM TESTING AND BALANCING SHALL BE PERFORMED BY INDEPENDENT AGENT CONTRACTED DIRECTLY BY THE OWNER. A RE-TEST IS MANDATORY FOR A FALSE START (I.E. NO POWER UPON AGENT'S ARRIVAL, EQUIPMENT NOT WIRED, ETC.) AND SHALL BE A COST INCURRED BY THE G.C. IN THE EVENT A SYSTEM / STORE RECEIVES A GRADE OF 5 OR BELOW AS A RESULT OF THE HVAC SYSTEM PERFORMANCE OR OPERATIONAL DEFICIENCIES, OWNER WILL REQUEST A RE-TEST AND THE COST FOR SAME SHALL BE ALSO INCURRED BY THE GENERAL CONTRACTOR.
- 17. THERMOSTATS; SEE SCOPE OF WORK.

SYMBOL & ABBREV.

Q

TS

——CD—

——UC—-

(X-X 0000)

SD

18. REMOTE THERMOSTAT SENSORS; SEE SCOPE WORK.

SA/SUP

RA/RET

EA/EXH

CD/SR

RR/RG

ER/EG

MVD

FD

FLEX

T-STAT

CD

DIA.

DL

UC

BDD

19. SUPPLY AIR TEMPERING (SAT) CONTROL; SEE SCOPE OF WORK. SAT FUNCTION: IF ROOM TEMPERATURE IS AT ESTABLISHED "SET-POINT", AND THE SUPPLY DUCT TEMPERATURE IS 10 DEGREES BELOW SET-POINT, SAT CONTROLS INITIATE FIRST STAGE HEATING TO PREVENT COLD AIR DRAFTS FROM ENTERING THE CONDITIONED SPACE.

SYMBOL & ABBREV.

CLG.

CONT.

CONT'R

CFM

DET.

DISC.

DTR

EF

(E)

GA.

GC

HVAC

MFR.

MECH.

(N)

OA/OSA

OBD

S/S

TYP.

UON

UTR

| | | | | | | | | DLING CAPA | 0111 | I IL/ (I O | APACITY | UNI | T ELECT D | | MAX | | | | |
|----------|-------------|-------------|---------------|-----------------|-----|-----|------|-------------|-----------------------------|------------|--------------|-------------------|--------------|-----|------|-------------------------|-------------------------------------|---------|--|
| XX-XXX A | AREA SERVED | AREA SERVED | SUPPLY CFM | MIN O.A. CFM | ESP | HP | RPM | NOM TONS | MIN CAP (MBH) TOT/SEN | MIN EER | ELEC (kw) | PHASE (STAGES) | VOLTS/ PH | MCA | MOCP | UNIT WEIGHT (LBS) | MANUFACTURER AND MODEL NUMBER | REMARKS | |
| RTU-1 | DINING | 3400 | 600 | 0.8 | 2.0 | 811 | 8.5 | 107.2/84.2 | 11.2 | 13.5 | 1 | 208/3 | 56 | 60 | 937 | TRANE TSC102 | SEE NOTES 1-6 | | |
| RTU-2 | KITCHEN | 5000 | 600 | 0.8 | 3.0 | 772 | 12.5 | 139.1/111.5 | 11.0 | 13.5 | 1 | 208/3 | 67 | 80 | 1375 | TRANE TSC150 | SEE NOTES 1-6 | | |

- LISTED CAPACITY IS GROSS COOLING CAPACITY AT 80°F DB/67°F WB EAT AND 95°F AMBIENT. OUTDOOR DESIGN CONDITION, SUMMER: 95°F DB & 74°F WB, WINTER: 17°F. ADJUST SELECTION BASED ON ACTUAL SITE CONDITIONS AND ACTUAL MOTOR HEAT. REFRIGERANT SHALL BE 410A.
- 2. SPECIFIED RTU'S ARE DOWN DISCHARGE PACKAGED ELEC/ELEC ROOFTOP UNITS WITH MINIMUM 2-STAGE COOLING. INCLUDES THROUGH THE ROOF CURB POWER & CONDENSATE DRAIN.
- 3. SPECIFIED UNIT INCLUDES HINGED ACCESS DOORS, 2" PLEATED FILTERS, 100% ECONOMIZER WITH BAROMETRIC RELIEF, CIRCUIT BREAKER WITH SINGLE POINT WIRING, HAIL GUARD, AND FACTORY FABRICATED, KNOCK-DOWN ROOF CURB.
- 4. SPECIFIED UNIT INCLUDES A UN-POWERED CONVENIENCE OUTLET AND SMOKE DUCT DETECTOR IN THE SUPPLY DUCT OF UNIT.
- 5. SPECIFIED UNIT INCLUDES FACTORY INSTALLED HOT GAS REHEAT OPTION
- 6. SUPPLY AIR TEMPERING (SEE GENERAL NOTE 19, THIS SHEET): WINTER DESIGN DB TEMP. 47 DEG. F OR LESS HOT GAS REHEAT: RTU-1 (DINING) SUMMER
- DESIGN WB TEMP. 74 DEG. F (OR GREATER). RTU-2 (KITCHEN) SUMMER DESIGN WB TEMP. 75 DEG. F (OR GREATER).

TRANE PACKAGE: FOR COMPLETE INFORMATION AND PRICING ON THE TRANE HVAC PACKAGE CONTACT MARTY CUSICK, THE YUM! BRANDS ACCOUNT EXECUTIVE AT TRANE NATIONAL ACCOUNTS. TOLL-FREE PHONE: (866) YUM-HVAC or (866) 986-4822

FAX: (502) 499-7870 EMAIL: mjcusick@trane.com

TRANE HAS AGREED TO SUPPLY AN HVAC PACKAGE CONSISTING OF THE ROOF-TOP UNITS, AND CURBS. RTU'S AS SPECIFIED INCLUDE AN UNPOWERED CONVENIENCE OUTLET (SEE ELECTRICAL) AND AN HACR CIRCUIT BREAKER WHICH PROVIDES UNIT DISCONNECT. TRANE ALSO HAS AVAILABLE OPTION PACKAGES WHICH INCLUDE SMOKE DETECTORS AND ENUNCIATORS, ECONOMIZERS, AND RTU VARIATIONS SUCH AS HIGH-EFFICIENCY MODELS.

BE PREPARED AT TIME OF ORDER OR QUOTE REQUEST TO PROVIDE ALL PROJECT DETAILS REGARDING SPECIFICATIONS AND QUANTITIES AS SITE SPECIFIC DESIGN MAY NOT MATCH NATIONAL DESIGN.

SEE THE SCOPE OF WORK SHEETS FOR ADDITIONAL INFORMATION.

| | | | | | | | | | | | | | | HVAC UNIT SCHEDULE | 1 |
|----------------|------|-----|------|-------|-------|---------|------|-----|----------------|--------|------|-------------------------------|---------------------------|---|---|
| | | | | | | ~ | | ACC | ESSOF | RIES | | | | REMARKS: | |
| XX XXX MARK | CFM | SP | RPM | HP | ELECT | STARTER | DISC | ВОО | BIRD SCREEN | V-BELT | D-DR | MANUFACTURER AND MODEL NUMBER | REMARKS | 1. UL 762 LISTED (GREASE) 2. VENTED ROOF CURB 3. ROOF CURB 4. GREASE TROUGH 5. LINGER ROOF CURB | |
| EF-1 | 1700 | 1.3 | 1414 | .75 | 115/1 | - | Х | | Х | Χ | | SVDU85HFA | SEE NOTES 1,2,3,4,5,6 & 9 | 5. HINGED ROOF CURB6. WEATHERPROOF DISCONNECT SWITCH7. SOLID STATE SPEED CONTROLLER | |
| EF-2 | 1700 | 1.3 | 1414 | .75 | 115/1 | - | Х | | Х | Х | | SVDU85HFA | SEE NOTES 1,2,3,4,5,6 & 9 | 8. BACKDRAFT DAMPER 9. EXHAUST FANS PROVIDED BY HOOD MANUFACTURER. | |
| EF-3 | 100 | 0.5 | 1075 | 135W | 120/1 | - | Х | Х | | | Χ | COOK GC-148 | SEE NOTES 7,8 | REFER TO HOOD DRAWINGS FOR MORE INFORMATION. | |
| EF-4 | 100 | 0.5 | 1075 | 135W | 120/1 | - | X | Х | | | X | COOK GC-148 | SEE NOTES 7,8 | | |
| MAU-1 | 2720 | 0.5 | 1019 | 1.0 W | 208/3 | _ | X | X | | | Х | SVAID.250610 | SEE NOTES 9 | | |

GENERAL NOTES

DESCRIPTION

CIRCUIT BREAKER

CONNECT/CONNECTION

CUBIC FEET PER MINUTE

CEILING

CONTINUATION

CONTRACTOR

DETAIL

DISCONNECT

EXHAUST FAN

GAGE/GAUGE

MANUFACTURER

MECHANICAL

OUTSIDE AIR

STAINLESS STEEL

UP THRU ROOF

TYPICAL

OPPOSED BLADE DAMPER

UNLESS OTHERWISE NOTED

NEW

GENERAL CONTRACTOR

HEATING, VENTILATING, AND AIR CONDITIONING

EXISTING

DOWN THRU ROOF

| | | | | | | | | | | | | | | | | | FAN SCHEDULE | 2 | |
|----------------|----------------------|--------------|----------------------------|----------|----------|-------|--------------------|--------|----------|--------|--------|---------|----------|-------|--------------------|---|---|---|--|
| | → DIFFUSER FACE TYPE | | | | | | AIR | NOU | MOUNTING | | DUTY | | MATERIAL | | | | | | |
| XX XXX MARK | QUANTITY | NECK SIZE | OR CEILING GRID SIZE | DIFFUSER | REGISTER | GRILL | PATTERN CFM RANGE | LAY-IN | SURFACE | SUPPLY | RETURN | EXHAUST | ALUMINUM | STEEL | MANUFACTURER | MODEL NUMBER | REMARKS | | |
| S-1 | , | AS NOTED | 24 x 24 | Χ | | | | X | | X | | | X | | METAL-AIRE / TITUS | 5000-6 / TDC-AA | FRN SQUARE to ROUND ADAPTER | | |
| S-4 | , | AS NOTED |) 12 x 12 | Χ | | | | X | Х | Х | | | X | | METAL-AIRE / TITUS | 5000-1 / TDC-AA | FRN SQUARE to ROUND ADAPTER | | |
| S-5 | | 14"Ø | 24x24 | Χ | | | | X | Х | Х | | | Х | | METAL-AIRE / TITUS | 7000 / PAS-AA | VERTICAL DISCHARGE | | |
| R-1 | | 22 x 22 | 24 x 24 | | | X | | X | | | X | | X | | METAL-AIRE / TITUS | CC5-FB-TB / 50FF | FRN SQUARE to ROUND ADAPTER, FULLY REMOVABLE FACE | | |
| | | | | | | | | | | | | | | | | BUILDING PL. REVIEW CODE CO! KEEP THIS P Building Inspection Sam West - September 16, 2 Examiner Signature | LAN ON JOB Division - Jax., FL. | | |
| NOTES: | | AUDEA OF A | AOLINITED OF UNI | 00.01 | | E DD0 | VIDED WITH OPPOSI | | | | | | | | | PLAN REVIEW OF PERMIT DO | DES NOT RELIEVE OF COMPLYING | | |

- 1. DIFFUSERS IN SURFACE MOUNTED CEILINGS SHALL BE PROVIDED WITH OPPOSED BLADE DAMPERS.
- 2. REFER TO ARCHITECTURAL DRAWINGS (A7.1, A7.2) FOR CEILING TYPES.

| | | | | UTDOOR AIR CALO HANICAL CODE - T | | | | | | ITEM | OA | RA | SA | EA | PRESSURE |
|----------|-----------|----------------|---------------------|-------------------------------------|----------------------------------|-------------|-------------------------------|---------------|----------|-------|------|------|------|------|----------|
| Existing | Area | Occupancy | Occupant Density | People outdoor airflow rate in | Area outdoor airflow rate in | | Required Zone outdoor airflow | |) | EF-1 | | | | 1700 | -1700 |
| Unit | (Sq Ft) | Classification | #/1000 Sq Ft | breathing zone, (Rp) cfm/person | breathing zone, (Ra) cfm/sqft | cfm/fixture | | airflow (cfm) | | EF-2 | | | | 1700 | -1700 |
| RTU-1 | 587 | DINING | 100 | 7.5 | 0.18 | - | 546 | 600 |) | EF-3 | | | | 100 | -100 |
| RTU-2 | 1027 | KITCHEN | 20 | 7.5 | 0.12 | - | 277 | 600 | | EF-4 | | | | 100 | -100 |
| | | | | | | Total | 823 | 1200 |) | RTU-1 | 600 | 2800 | 3400 | | +600 |
| EF-1 | 2 FIXT | RESTROOMS | - | - | - | 70 | 140 | 200 | | RTU-2 | 600 | 4400 | 5000 | | +600 |
| | | | | | 1 | | 1 | | | MAU-1 | 2720 | | | | +2720 |
| | | | | | | | | |) | | | | | | |
| | | | | | | | | | | | | | | | |
| | | | | | | | | | | | | | | | |
| | | | | | | | | | | TOTAL | 3920 | 7200 | 8400 | 3600 | +320 |

SIGNED AND SEALED BY ROBERT WAYNE CASE, PE ON JUNE 24, 2022 USING A DIGITAL SIGNATURE. PRINTED COPIES OF THIS DOCUMENT ARE NOT

CONSIDERED SIGNED AND SEALED AND THE SIGNATURE MUST BE VERIFIED ON ANY ELECTRONIC COPIES. Digitally signed by

12:05:07

ROBERT WAYNE CASE FLORIDA PE. #44643

| PLAN SET REVISIONS: |
|------------------------------|
| 06/22/22 - BUILDING COMMENTS |
| 09/12/22 - BUILDING COMMENTS |
| \triangle |
| \triangle |
| \triangle |
| \triangle |
| |

CONTRACT DATE: Kb 30-19 BUILDING TYPE:

PLAN VERSION: SITE NUMBER: **ENTITY NUMBER:**

STORE NUMBER: LIS PROJECT; 2019-303

OAKLEAF CORNER OUTPARCEL 3 DUVAL COUNTY, FL



MECHANICAL


SCHEDULES AND NOTES

MECHANICAL SYMBOLS

12 **OUTDOOR AIR CALCULATIONS**

AIR BALANCE SCHEDULE CFM

THE HOOD FIRE SUPPRESSION CONTRACTOR SHALL SUBMIT PLANS FOR EVALUATION AND APPROVAL PRIOR TO COMMENCEMENT OF NEW WORK.

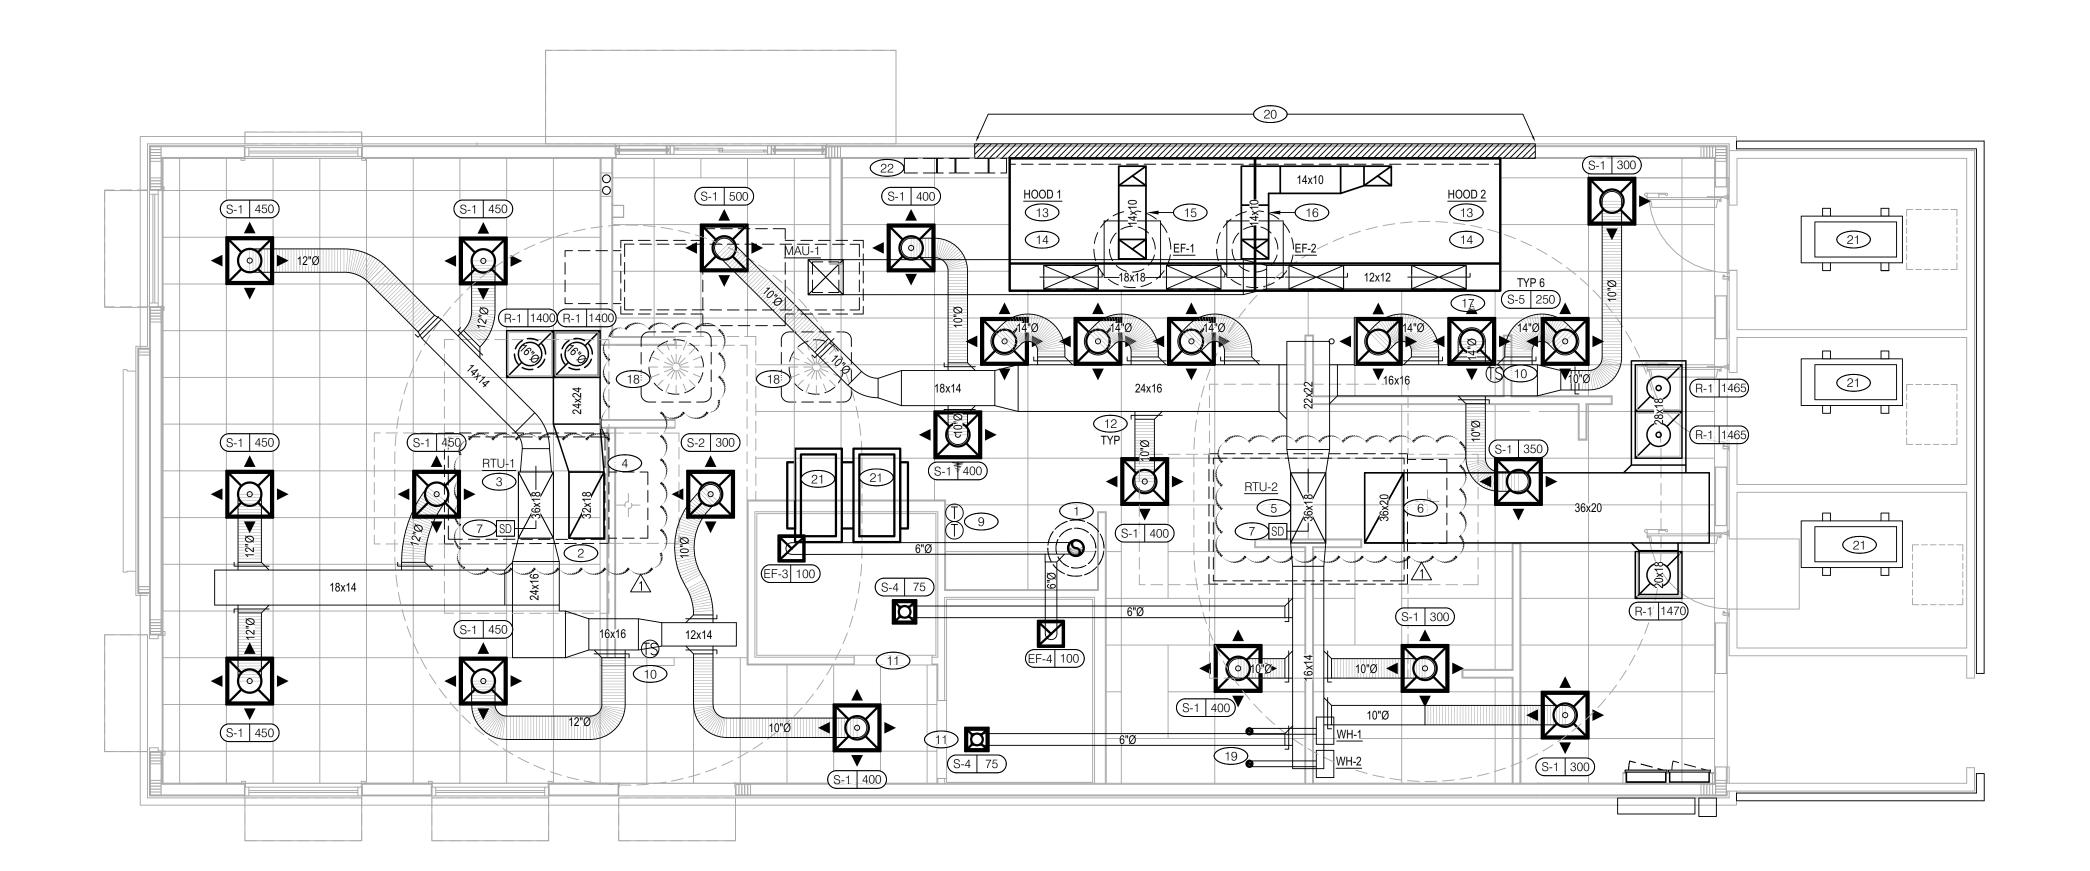

PROVIDE SECONDARY CONDENSATE PROTECTION IN COMPLIANCE WITH FBC - MECH 307.2.3 AND RELATED SUBSECTIONS. PROVIDE SAFETY SHUT-OFF SWITCHES IN CONDENSATE DRAINS.

DUCT AND DIFFUSER PLAN 1/4"=1'-0" A

- A. INSTALLATION AND TERMINATION OF THE POWERED VENT SYSTEM FOR THE WATER HEATER SHALL BE IN ACCORDANCE WITH THE VENT AND WATER HEATER MANUFACTURER'S INSTALLATION INSTRUCTIONS, AND LOCAL CODES AND REQUIREMENTS.
- B. DINING ROOM / KITCHEN LIGHT FIXTURE LOCATIONS ARE CRITICAL. COORDINATE DUCTWORK LOCATIONS SO AS NOT TO CONFLICT WITH LIGHT FIXTURE LOCATIONS. COORDINATE WITH ELECTRICAL DRAWINGS FOR CEILING GRID / LIGHT FIXTURE LOCATIONS.
- C. THERMOSTATS SHALL BE PROGRAMMABLE WITH SUBBASE AND REMOTE TEMPERATURE SENSOR; REFER TO KEYNOTES 9 and 10, THIS SHEET.
- D. S/A DUCTS FOR RTU-1 (FRONT of HOUSE) SHALL RUN WITHIN THE TRUSS WEB SPACE; COORDINATE WITH STRUCTURAL DRAWINGS. SEE DETAIL 1 / S4.2.
- 8"Ø EXHAUST AIR DUCT UP TO ROOF MOUNTED MUSHROOM CAP, 200 CFM. SEE DETAIL 2 ON SHEET M4.0. PROVIDE BACKDRAFT DAMPER IN EACH EXHAUST DUCT CONNECTING EXHAUST FAN TO 8"Ø EXHAUST DUCT. EXHAUST FANS + MOTOR DAMPERS SHALL BE WIRED TO RESTROOM LIGHTS AND CONTROLLED BY MOTION SENSOR; COORDINATE WITH ELECTRICAL.
- THE INSIDE OF THE RETURN AIR DUCTS SHALL BE LINED FROM THE AIR HANDLING EQUIPMENT TO A DISTANCE OF 10' FROM THE UNIT WITH ULTRALITE #300 - 1/2" THICK OR OTHER APPROVED DUCT LINEAR ACOUSTICAL BOARD. THE MATERIAL SHALL BE FITTED CAREFULLY ON THE INSIDE OF THE DUCT AND SHALL BE FASTENED ON WITH CEMENT SUPPLEMENTED BY SCREWS AND WASHERS ON TOP AND SIDES OF DUCT.
- 32 x 16 SUPPLY AIR DUCT: CONNECT TO SUPPLY AIR OPENING AT ROOFTOP UNIT, RTU-1 (COORDINATE WITH RTU SUPPLIER / SPECIFICATIONS).
- 32 x 18 RETURN AIR DUCT: CONNECT TO RETURN AIR OPENING AT ROOFTOP UNIT, RTU-1 (COORDINATE WITH RTU SUPPLIER / SPECIFICATIONS).
- 36 x 18 SUPPLY AIR DUCT: CONNECT TO SUPPLY AIR OPENING AT ROOFTOP UNIT, RTU-2 (COORDINATE WITH RTU SUPPLIER / SPECIFICATIONS).
- 36 x 20 RETURN AIR DUCTS: CONNECT TO RETURN AIR OPENING AT ROOFTOP UNIT, RTU-2 (COORDINATE WITH RTU SUPPLIER / SPECIFICATIONS).
- FURNISH AND INSTALL SMOKE DETECTOR IN THE SUPPLY AIR DUCT, IN ACCORDANCE WITH LOCAL CODES. DUCT SMOKE DETECTOR WIRED BY ELECTRICAL CONTRACTOR, COORDINATE WITH ELECTRICAL.
- FURNISH AND INSTALL 3" SCHEDULE 40 PVC WATER HEATER CONCENTRIC VENT TO ROOF. COORDINATE WORK WITH ALL TRADES.

- 9 THERMOSTAT.
- THERMOSTAT REMOTE SENSOR . MOUNT at 60" A.F.F.
- 11) UNDERCUT RESTROOM DOORS MIN. 1/2" FOR MAKE-UP AIR.
- PROVIDE MANUAL VOLUME DAMPER, TYPICAL AT ALL SUPPLY AIR AND RETURN AIR DIFFUSERS, IN ACCESSIBLE LOCATION WHENEVER POSSIBLE. FOR NON ACCESSIBLE LOCATIONS PROVIDE REMOTE CABLE CONTROL UNIT BOWDEN MODEL 270-301 AS MANUFACTURED BY YOUNG REGULATOR CO. OR APPROVED EQUAL.
- (13) CANTILEVER HOOD SUPPORT RODS AWAY FROM DUCTWORK. USE ANGLE TO OFFSET THE SUPPORTS.
- 14) SUPPLY, RETURN, OR EXHAUST DUCTWORK RUN BETWEEN ROOF TRUSSES.
- 15 14 x 10 EXHAUST AIR DUCT DOWN, TRANSITION AS NECESSARY TO CONNECT TO EXHAUST HOOD. EXHAUST DUCT SHALL OFFSET IN CEILING SPACE TO CONNECT TO ROOF EXHAUST FAN EF-1. SEE HOOD DETAILS ON DRAWING M3.0. SEE DETAILS ON SHEET M4.0 FOR FIRE PROTECTION OF DUCTWORK.
- 16 14 x 10 EXHAUST AIR DUCT DOWN, TRANSITION AS NECESSARY TO CONNECT TO EXHAUST HOOD. EXHAUST DUCT SHALL OFFSET IN CEILING SPACE TO CONNECT TO ROOF EXHAUST FAN EF-2. SEE HOOD DETAILS ON DRAWING M3.0. SEE DETAILS ON SHEET M4.0 FOR FIRE PROTECTION OF DUCTWORK.
- MAKE-UP AIR CONNECTION TO HOOD PLENUM. BALANCE TO 680 CFM EACH (TYP OF 4) 18 MAKE-UP AIR CONDENSING UNIT ON ROOF EQUIPMENT STAND BY G.C.

- FURNISH AND INSTALL 3" SCHEDULE 40 PVC CONCENTRATE WATER HEATER INTAKE/VENT TERMINATION. RUN THRU WEBS TO OUTFALL AT VENT ON ROOF.
- EXTERIOR HOOD WALL SHALL BE MTL STUD FRAMING, CEMENT BOARD WITH STAINLESS COVER EXTENDING 18" BEYOND ALL SIDES. SEE SHEET A5.2 FOR WALL
- COORDINATE LOCATION OF REFRIGERATION CONDENSING UNITS FOR ICE MACHINES, COOLERS AND FREEZERS.
- HOOD FIRE SUPPRESSION SYSTEM, SEE SHEET M3.1.

THIS ITEM HAS BEEN ELECTRONICALLY SIGNED AND SEALED BY ROBERT WAYNE CASE, PE ON JUNE 24, 2022,

COPIES OF THIS DOCUMENT ARE NOT CONSIDERED SIGNED AND SEALED AND THE SIGNATURE MUST BE VERIFIED ON ANY ELECTRONIC COPIES. Digitally signed by

ROBERT W 2022.09.12 12:05:29

ROBERT WAYNE CASE FLORIDA PE. #44643

PLAN SET REVISIONS: 1 06/22/22 - BUILDING COMMENTS

2 09/12/22 - BUILDING COMMENTS

CONTRACT DATE: 12-18-2019 BUILDING TYPE: Kb 30-19

PLAN VERSION: SITE NUMBER:

> **ENTITY NUMBER:** STORE NUMBER: LIS PROJECT;

> > KFC

2019-303


OAKLEAF CORNER OUTPARCEL 3 DUVAL COUNTY, FL




MECHANICAL **DIFFUSER AND DUCT PLAN**

M2.0

D

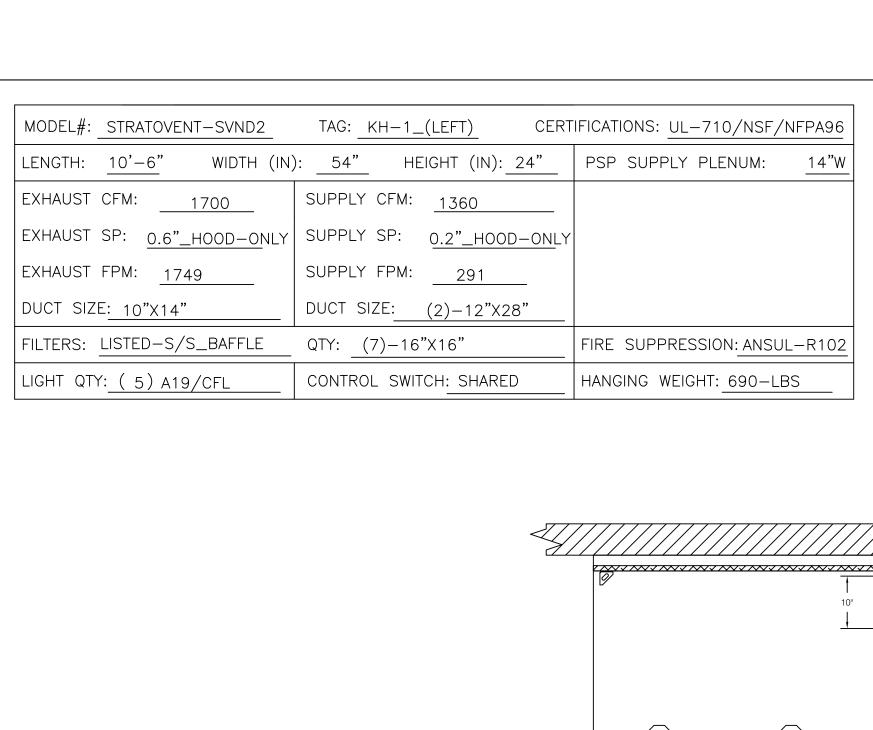

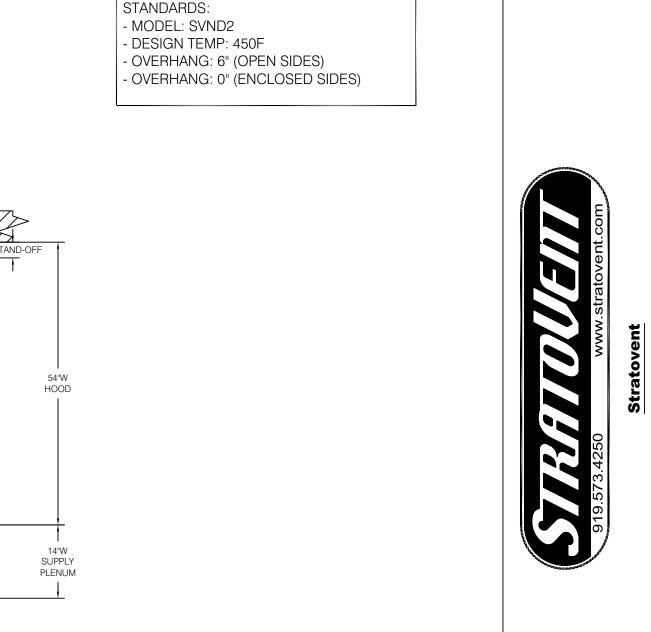

STRATOVENT HOODS

NFPA #96


NSF STANDARD #2

UL STANDARD 710

FRONT SUPPLY PLENUM

BY ALL-THREAD.

SHIPS LOOSE. FIELD INSTALLED AND SUPPORTED

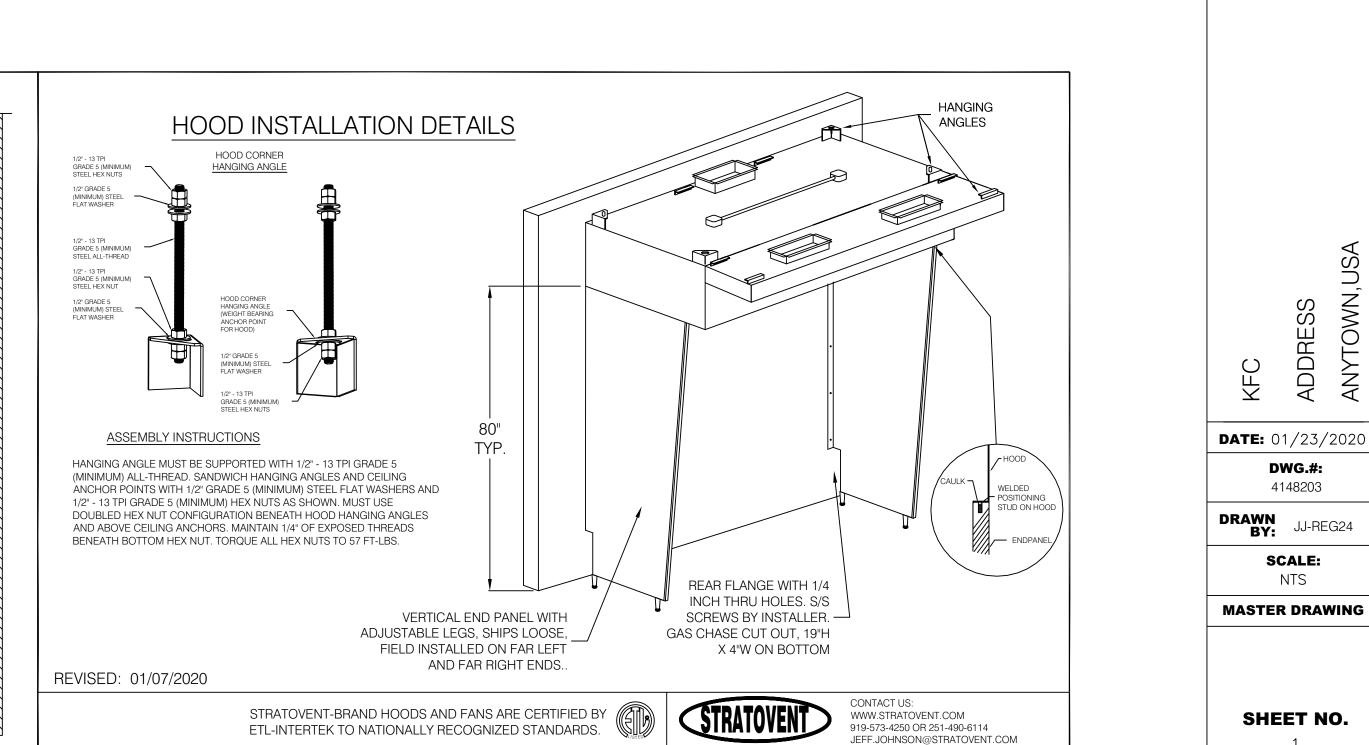

THIS ITEM HAS BEEN ELECTRONICALLY SIGNED AND SEALED BY ROBERT WAYNE CASE, PE ON JUNE 24, 2022, USING A DIGITAL SIGNATURE. PRINTED COPIES OF THIS DOCUMENT ARE NOT CONSIDERED SIGNED AND SEALED AND THE SIGNATURE MUST BE VERIFIED ON ANY ELECTRONIC COPIES. ROBERT WAYNE CASE FLORIDA PE. #44643 PLAN SET REVISIONS: 1 06/22/22 - BUILDING COMMENTS

REVISIONS DESCRIPTION

CONTRACT DATE: 12-18-2019 BUILDING TYPE: Kb 30-19 PLAN VERSION: SITE NUMBER: **ENTITY NUMBER:** STORE NUMBER: LIS PROJECT; 2019-303 KFC

OAKLEAF CORNER OUTPARCEL 3 DUVAL COUNTY, FL

Digitally signed by **ROBERT W**

2022.09.12

12:05:56

-04'00'


2 09/12/22 - BUILDING COMMENTS



HOOD PLAN ELEVATIONS AND SECTIONS


B-22-511575.000

M3.0

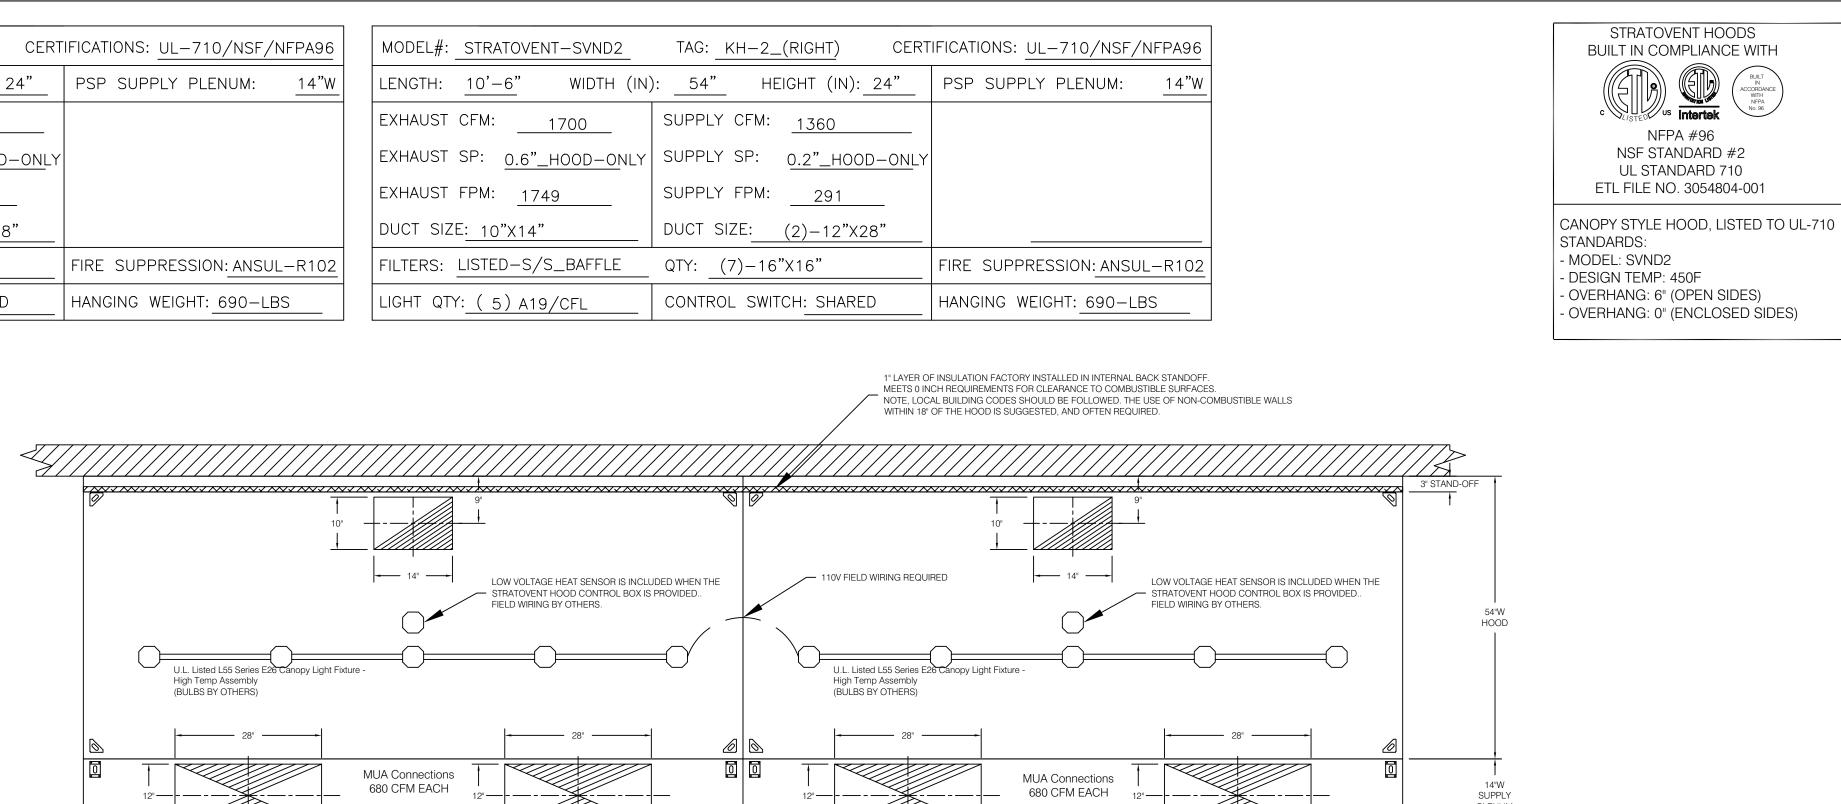


10' 6.00"Nom./10' 6.00"OD


PLAN VIEW - Hood #2

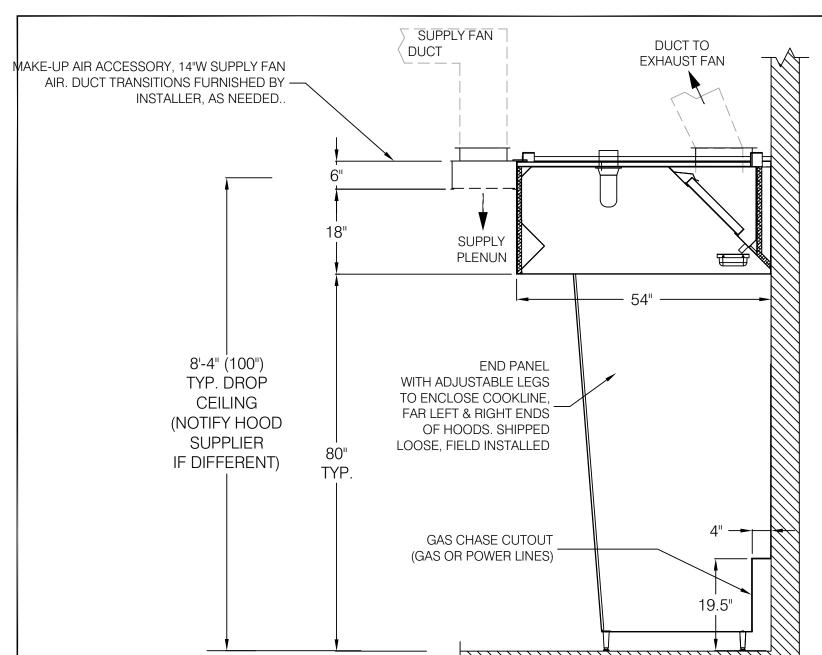



SECTION VIEW

<u> PLAN VIEW - Hood #1</u>

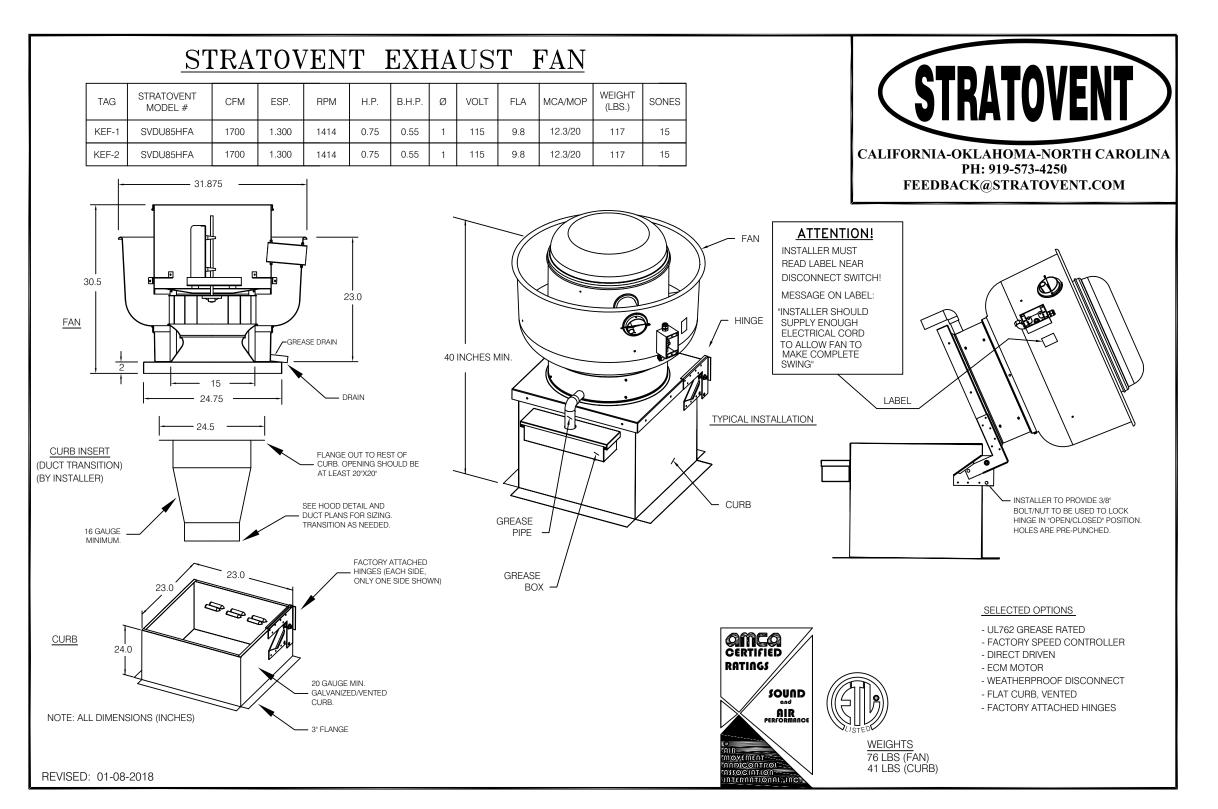

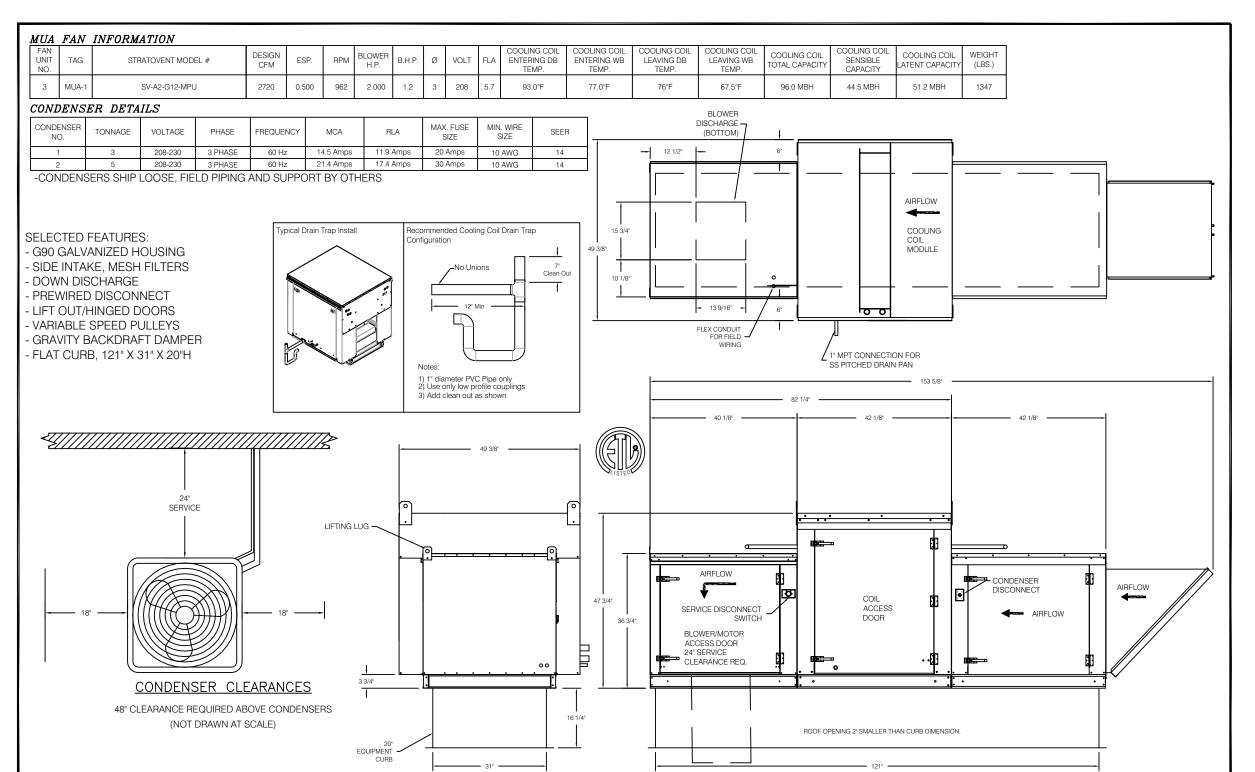

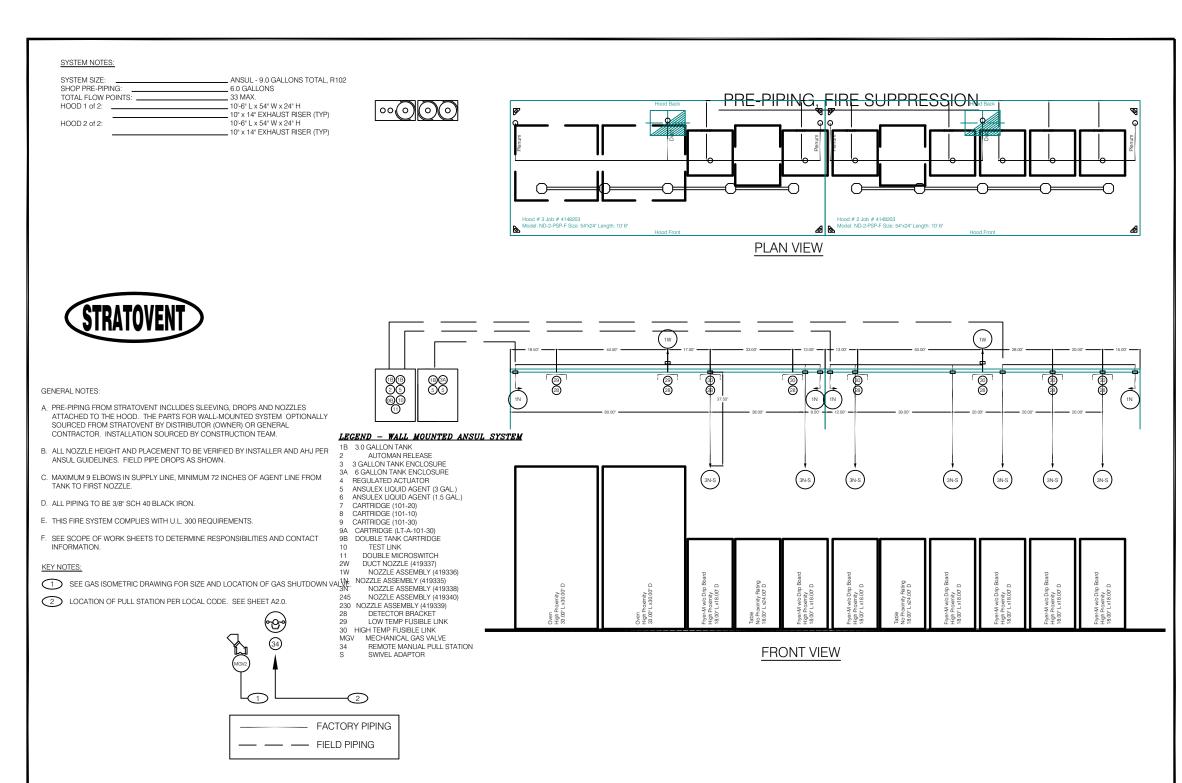

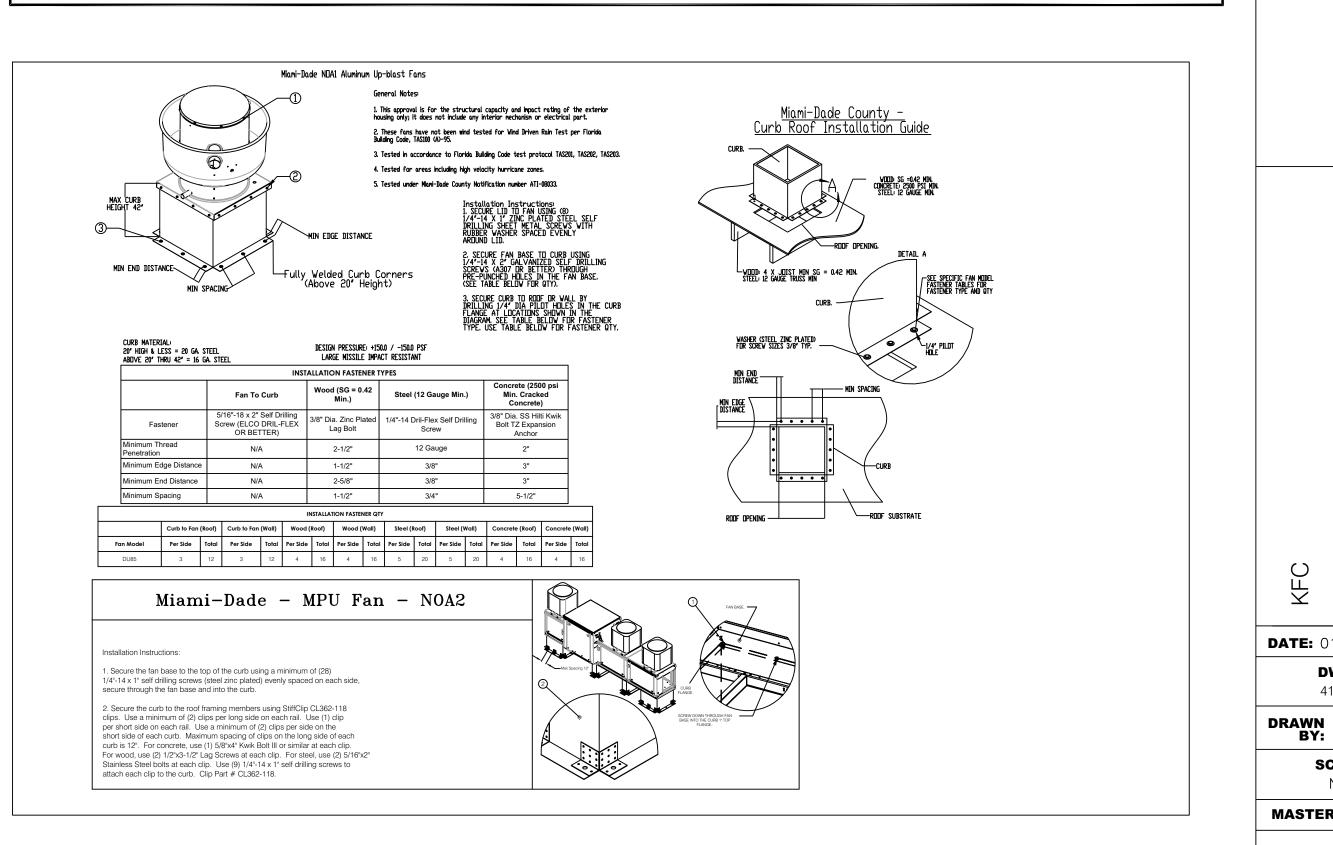

DESCRIPTION BUILDING TYPE: PLAN VERSION: SITE NUMBER: ENTITY NUMBER: STORE NUMBER: LIS PROJECT; **DATE:** 01/07/2020 JJ-REG24

THIS ITEM HAS BEEN ELECTRONICALLY SIGNED AND SEALED BY ROBERT WAYNE CASE, PE ON JUNE 24, 2022, COPIES OF THIS DOCUMENT ARE NOT CONSIDERED SIGNED AND SEALED AND THE SIGNATURE MUST BE VERIFIED ON ANY ELECTRONIC COPIES.

> Digitally signed by ROBERT W Date: 2022.09.12 12:06:21 -04'00'

ROBERT WAYNE CASE FLORIDA PE. #44643

PLAN SET REVISIONS: √1 06/22/22 - BUILDING COMMENTS 2 09/12/22 - BUILDING COMMENTS

CONTRACT DATE: 12-18-2019 Kb 30-19

KFC

OAKLEAF CORNER OUTPARCEL 3 DUVAL COUNTY, FL

2019-303



HOOD PLAN ELEVATIONS AND SECTIONS

M3.1

ADDRESS


DWG.#:

4148203

SCALE:

MASTER DRAWING

SHEET NO.

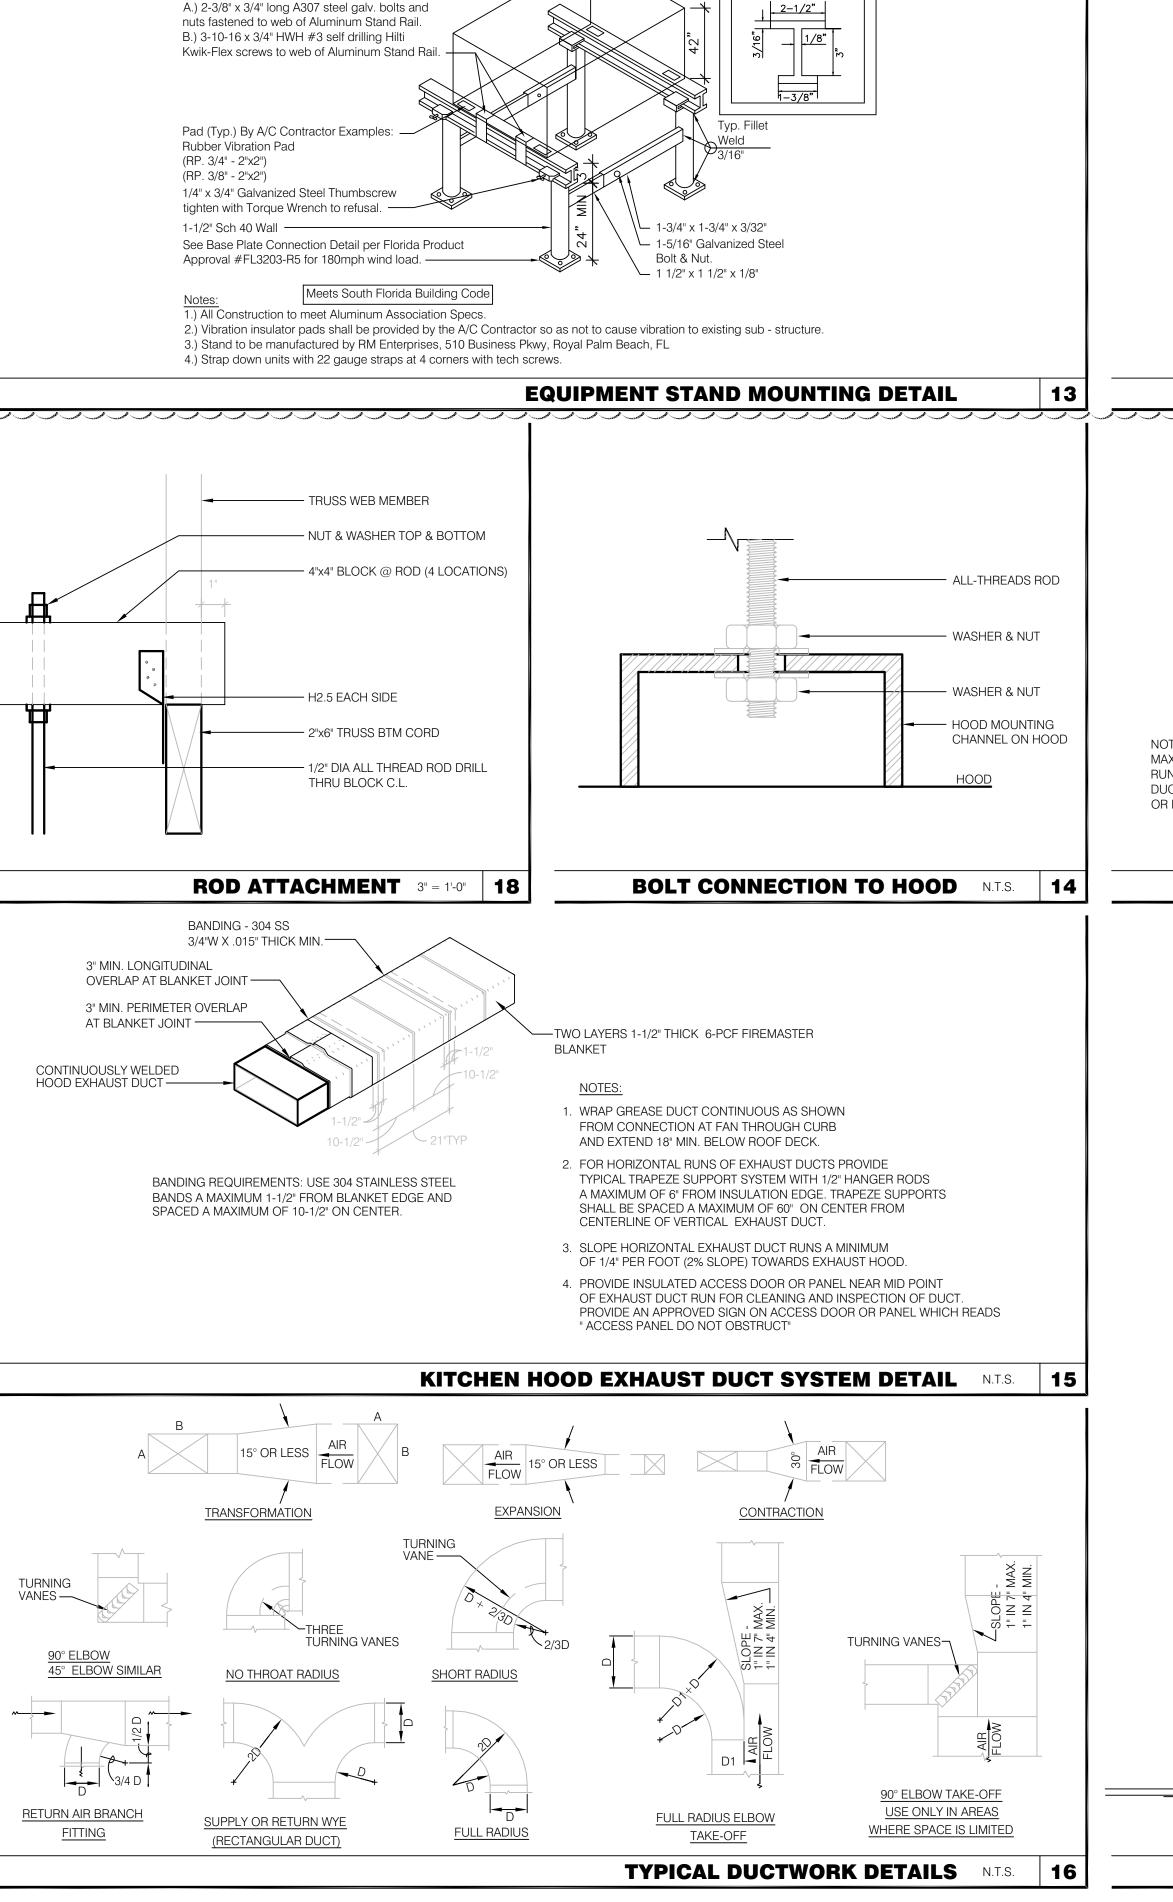



— (Typ.) CONDENSING


Rail Section

Provide 4-22 ga.- 1 1/8" wide hurricane straps per


A/C unit.

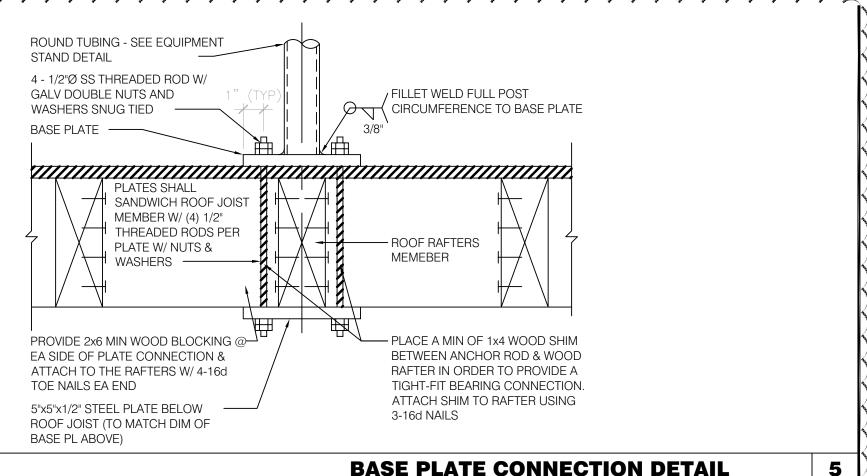


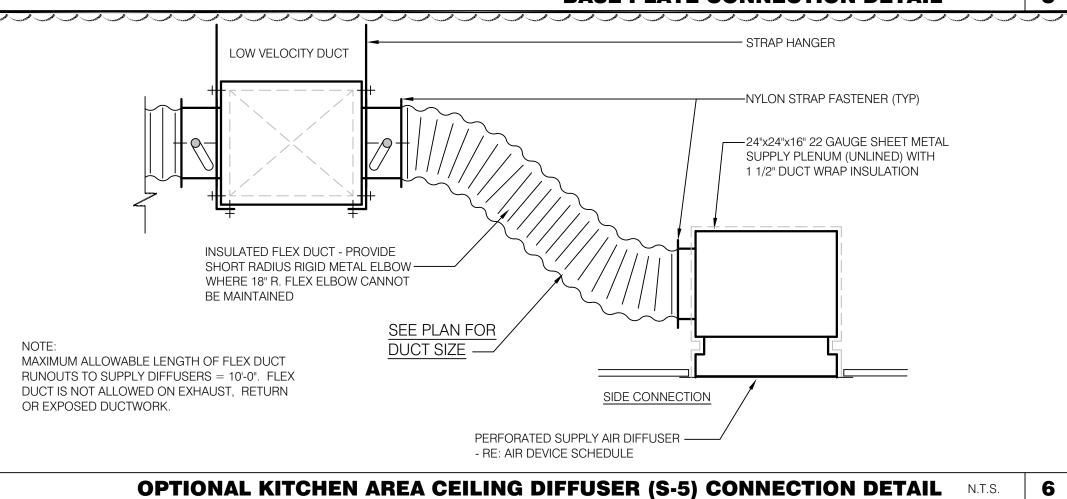

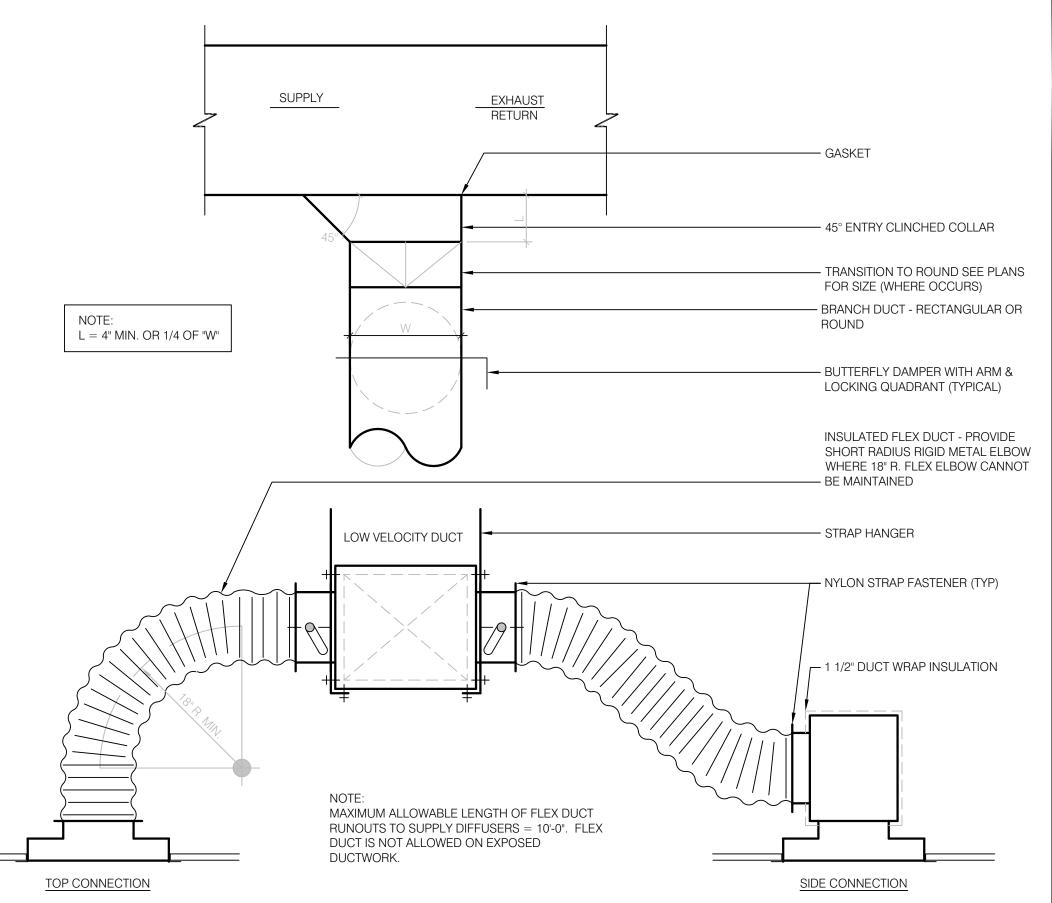

CEILING DIFFUSER CONNECTIONS 3/8" = 1'-0" 8

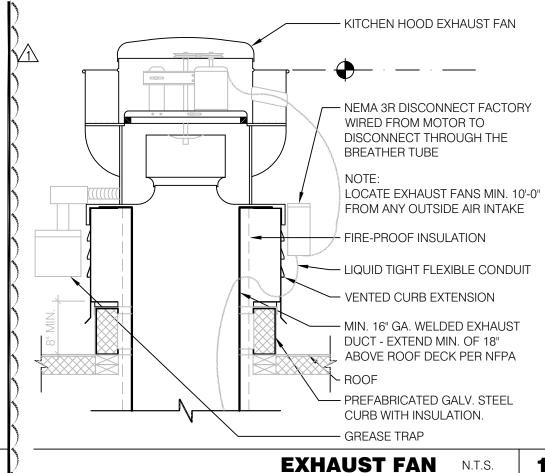

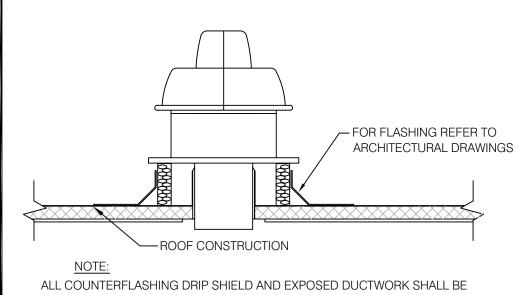

18 GA. GALVANIZED SHEETMETAL ALL SOLDERED AIR-TIGHT CONSTRUCTION.

ROOF MOUNTED EXHAUST CAP N.T.S.

GENERAL NOTES

- 1. Exhaust duct collars may be field cut
- 2. Exhaust duct air flow velocity shall be greater than 1500 FPM, lower if allowed by local codes.
- 3. Exhaust air flows must be balanced upon installation.
- 4. Fan operating speed should be rechecked after 60 days to ensure proper performance. Static pressure values are given for the hood only (unless otherwise noted).

SPECIFICATIONS

- 1. Hoods shall be constructed of minimum 20 gauge stainless steel with # 3 polish. All unexposed surfaces shall be constructed of minimum 18 gauge aluminized steel.
- 2. UL classified aluminum or stainless steel baffle-type filters shall be easily removed for cleaning. Filter housing shall terminate in a pitched grease trough that drains into a removable stainless steel grease cup.
- 3. UL listed and NSF approved vapor proof light fixtures pre- wired to junction box at top of hood in accordance with NEC 70. Lamps to be screw-in CFL, provided by others.
- 4. Pre-piped fire suppression systems shall be located on the top of the hood and provided with the hood or by a certified technician. Final location of all nozzles and fire suppression drops to be locally approved and inspected.
- 5. Hood(s) shall be fabricated in accordance with NFPA Bulletin #96 and shall bear the NSF Seal of Approval. Hoods shall be listed under UL 710 EXHAUST HOODS FOR COMMERCIAL COOKING EQUIPMENT, Certified by ETL under FILE# 3054804-001.







THIS HOOD DESIGN IS BASED UPON STRATOVENT, MODEL SVND2. MANUFACTURED BY:

STRATOVENT VENTILATION HOODS RALEIGH, NC 27616 CONTACT: JEFF JOHNSON, 251-490-6114

ARCHITECTURE ENGINEERING

THIS ITEM HAS BEEN ELECTRONICALL SIGNED AND SEALED BY ROBERT WAYNE CASE, PE ON JUNE 24, 2022, COPIES OF THIS DOCUMENT ARE NOT CONSIDERED SIGNED AND SEALED AND THE SIGNATURE MUST BE VERIFIED ON ANY ELECTRONIC COPIES.

Digitally signed by 2022.09.12

12:06:48

ROBERT WAYNE CASE FLORIDA PE. #44643

| PLAN SET REVISIONS: |
|------------------------------|
| 06/22/22 - BUILDING COMMENTS |
| 09/12/22 - BUILDING COMMENTS |
| \triangle |
| \triangle |
| \triangle |

CONTRACT DATE: 12-18-2019 BUILDING TYPE: Kb 30-19

PLAN VERSION: SITE NUMBER:

ENTITY NUMBER: STORE NUMBER:

LIS PROJECT;

KFC

2019-303

OAKLEAF CORNER OUTPARCEL 3 DUVAL COUNTY, FL



MECHANICAL SYSTEM DETAILS

HOOD NOTES AND SPECS (TYP.