FOOD SERVICE PLAN REVIEW

Reviewer Andrea Reese Date 08/29/2022

Plans are in compliance subject to:

1) Compliance with applicable state and local codes.

2) Compliance with all provisos on specification worksheet.

See Comments on Specification Sheet

File# 346346

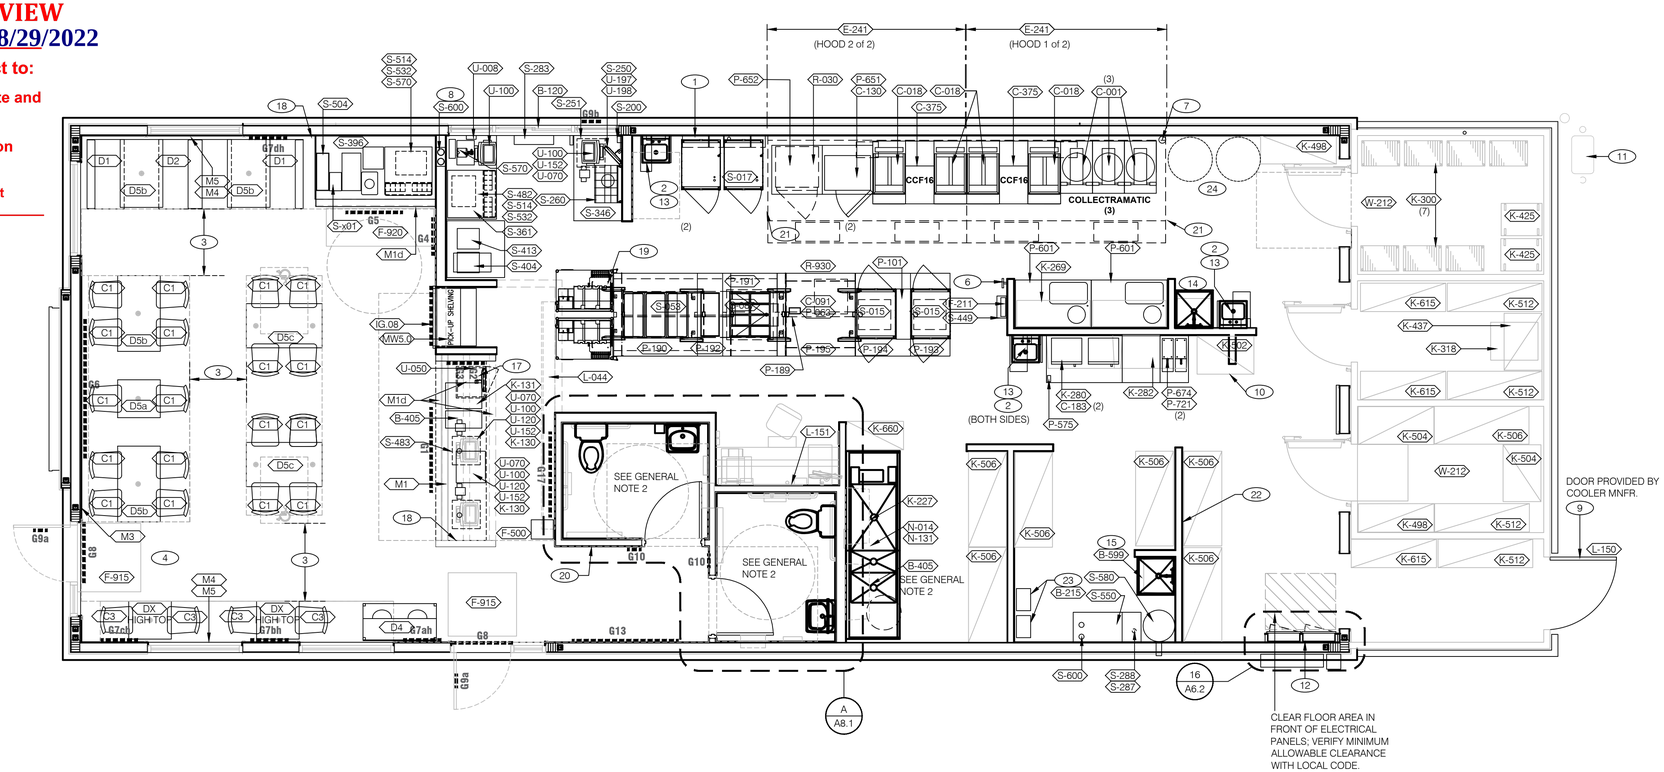

EQUIPMENT / SEATING PLAN 1/4"=1'-0" **A**

GRAPHICS

G1	1	"KITCHEN" SIGN	IG.08	1	SKIP THE LINE GRAPHIC
G1a	1	"ORIGINAL RECIPE" COUNTER GRAPHIC			
G2	1	CHALK BOARD "FRESH FROM THE FARM" SIGN			
G3	1	REAL MEALS GUARANTEE			
G4	1	SECRET PROCESS ART			
G5	1	PEPSI FILLING STATION SIGN			
G6	1	FOCAL WALL ART			
G7	2	ARTWORK HANGING SYSTEM			
G7ah	1	DINNING ROOM ARTWORK - "SOUTHERN INSPIRED"			
G7bh	1	DINNING ROOM ARTWORK - "4000 STATUES"			
G7ch	1	DINNING ROOM ARTWORK - "No 1 CHICKEN SALESMAN"			
G7dh	1	DINNING ROOM ARTWORK - "SANDERS FOR SENATOR"			
G8	1	"THANKS" MESSAGE			
G9a	1	STORE HOURS - ENTRY DOOR			
G9b	1	STORE HOURS - DT WINDOW			
G9c	1	STORE HOURS - SPEAKER POST			
G10	2	RESTROOM SIGNS			
G13	1	COMMUNITY MESSAGE			
G15a	1	BOH ART - COMMUNICATION BOARD (VERT. & HORIZ.)			
G15b	1	BOH ART - FAMILY PRIDE BOARD			
G15c	1	BOH ART - COLONEL PROUD BOARD			
G15d	1	BOH ART - COLONEL TIE MIRROR			
G15e	1	BOH ART - GREATEST CHICKEN COLLAGE			
G15f	1	BOH ART - SERVICE PROMISE SIGN			

IMAGE COMPONENT SCHEDULE **E**

SEATING PACKAGE LEGEND - BY DECOR VENDOR U.O.N. (TOTAL SEATS = 30)

TAG	QTY.	DECOR VENDOR #	ITEM	REMARKS
C1	18		CAFE DINING CHAIRS	
C2	-		CAFE DINING CHAIRS - KFC RED SEAT	
C3	4		CAFE BAR CHAIRS - KFC RED SEAT	
D1	2		SANDERS BOOTH SINGLE (3'-10"W x 3'-8"L)	
D2	1		SANDERS BOOTH DOUBLE (3'-10"W x 3'-8"L)	
D3	-		TRASH UNIT - SINGLE	
D4	1		TRASH UNIT - DOUBLE	
D5a	1		TABLE TOP - 21" x 24"	
D5b	4		TABLE TOP - 24" x 42"	
D5c	2		TABLE TOP - 28" x 48" (SIDE LEGS) HC W/ SYMBOL	
DX	2		HIGH TABLE TOP - 21" x 24"	
IS1	1		BUCKET	
IS2	1		RING CEILING ELEMENT	
M1	1		ORDER COUNTER/DRINK COUNTER COMPONENTS	
M1d	1 EA.		FRONT COUNTER SYSTEM W/ DIVIDER WALL W/ BEAM SYSTEM DRINK STATION W/ BEAM SYSTEM	
M2	1		ENTRY FOCAL WALL WITH REAL MEALS QUOTE - STANDARD	5'-0" MIN. OR 8'-0" MAX
M3	1		FOCAL WALL PANELS - BACK RED WALL W/ WINDOWS & TOP TRIM	
M4	-		WINDOW TRIM	
M5	5		CROWN MOULDING	10'-0" LENGTH
M6	-		BUCKET BOOTH WITH BAR COUNTER/CURVED GLASS DIVIDER SCREEN	
M7	-		CONDIMENT STATION	
MW5.0	1		PICK UP SHELVING	FCI

SEATING PACKAGE LEGEND - BY DECOR VENDOR U.O.N. (TOTAL SEATS = 30) **D**

1. REFER TO SCOPE OF WORK FOR RESPONSIBILITIES.
2. SEE SHEET A8.1 FOR ENLARGED RESTROOM AND OFFICE PLAN.
3. (HC) - SYMBOL DENOTES A HANDICAP ACCESSIBLE TABLE.
4. ◉ - SYMBOL INDICATES CORE DRILL LOCATION (FOR REFERENCE ONLY).
   CORE DRILLS SHALL BE LOCATED FROM APPROVED DECOR VENDOR SHOP DRAWINGS and
   FIELD COORDINATION WITH G.C. DO NOT LOCATE PER THESE DRAWINGS.
5. REFER TO DESIGN REFERENCE MANUAL (PLANS.YUM.COM) FOR FINISHES, DIMENSIONS and DETAILS OF DECOR VENDOR SUPPLIED ITEMS. SEE SEATING PACKAGE LEGEND, THIS SHEET.
6. REFER TO SHEET A2.1 FOR EQUIPMENT TAG REFERENCES.

* THE NUTRITION MATERIALS (ACRYLIC HOLDER, NUTRITION POSTER AND BRAND NUTRITION BROCHURES) ARE PART OF A NEW RESTAURANT'S GRAND OPENING KIT AND ARE PROVIDED BY YUM FORMS.

GENERAL NOTES **C**

1. HOOD FIRE SUPPRESSION SYSTEM; SEE SHEET M3.1.
2. SPLASH GUARD at HAND SINK; SEE DETAIL 7 / A6.3.
3. MAINTAIN 44" MIN CLEAR AISLE EGRESS PATHS TO EXIT DOORS.
4. 30" x 48" CLEAR FLOOR SPACE FOR HANDICAP ACCESS.
5. NOT USED
6. PULL STATION @ 3'-8" A.F.F.
7. GAS LINE DOWN TO EQUIPMENT; SEE SHEETS P3.0, P5.0.
8. PVC CHASE (QTY. 2) FOR SYRUP / FILTERED WATER TUBE BUNDLE. COORDINATE w/ 8" x 12" WALL OPENING; SEE ELEVATIONS 1 / A8.0 and 5 / A8.2. PROVIDE FILTERED WATER CONNECTION FOR TEA BREWER S-404.
9. SEE SHEET A1.1 FOR SECURITY DOOR PACKAGE. COOLER MANUFACTURER DOOR TO PROVIDE SECURITY HARDWARE AND FUNCTION.
10. SAUCE DISPENSING BRACKET; ATTACH TO STORAGE SHELF.
11. GAS METER (SEE CIVIL FOR LOCATION).
12. SWITCHGEAR / ELECTRIC PANELS; SEE SHEET E4.0.
13. B-241 B-251 B-290 B-405 N-053 N-133 N-150
14. B-620 N-071 N-202
15. B-599 N-071 N-202
16. NOT USED
17. SAFE. SEE DETAIL 9/A6.3.
18. MILLWORK WALL PANELS. COORDINATE WITH MILLWORK VENDOR
19. NEW PACK-LINE COORDINATE EQUIPMENT ORDER WITH EQUIPMENT VENDOR.
20. INSTALL FOUNDATION ARTWORK AT 5'-6" A.F.F. TO CENTER.
21. INSTALL VERTICAL END PANELS. PROVIDED BY HOOD MANUFACTURER
22. PROVIDE 2X4 WOOD BLOCKING FOR SHELVING AND ALL HAND SINKS (TYP.)
23. TANKLESS WH SYSTEM - SEE MEP DRAWINGS
24. RTI SYSTEM

KEYNOTES **B**

LIS ARCHITECTURE ENGINEERING
LAND INVESTMENT SERVICES, LLC
AA 26002040 CA NO: 6853 LB1057
ARCHITECTURE / ENGINEERING OFFICE
2572 West State Road 426
Suite 2064, Oviedo, FL 32765
Phone: (321) 244-0402
facsimile: (321) 244-9419
ENGINEERING OFFICE
21430 Palm Beach Blvd.
Alva, Fla. 33920
Phone: (239) 693-9244
facsimile: (239) 693-9828
HAROLD DANIEL HUTTER III
FL. REG. AR98913

PLAN SET REVISIONS:

1 06/22/22 - BUILDING COMMENTS

CONTRACT DATE:	12-18-2019
BUILDING TYPE:	Kb 30-19
PLAN VERSION:	
SITE NUMBER:	
ENTITY NUMBER:	
STORE NUMBER:	
LIS PROJECT;	2019-303

KFC

OAKLEAF CORNER OUTPARCEL 3
DUVAL COUNTY, FL

Kb 30-19

EQUIPMENT PLAN and SEATING PLAN

A2.0

PLOT DATE: 03/29/2022

EQUIPMENT SCHEDULE

NO.	QTY	G.C. INST.	ITEM DESCRIPTION	MFR. & MODEL NUMBER	PLUMB	ELECT	GAS	REMARKS	NO.
			B CONTRACTOR BUILDING ELEMENTS						
B-120	1	X	DRIVE-THRU WINDOW	QUICKSERV #SC4030CR				CLEAR ANODIZED	B-120
B-215	2	X	WATER HEATER (TANKLESS)	RINNAI / MODEL: RL94i (REU-VC2837FFUD-US)	X	X	X	SEE A/P1.0 PLUMBING SCHEDULE WH-1 & WH-2	B-215
B-241	5	X	SOAP DISPENSER (WALL MOUNT)	KAY 3675				SURFACE MOUNTED	B-241
B-251	3	X	SANITIZER DISPENSER	KAY 3741				SURFACE MOUNTED	B-251
B-265	2	X	MIRROR, 18" X 36"	BOBRICK #B-165-1836				SURFACE MOUNTED	B-265
B-275	2	X	TOILET PAPER DISPENSER	BOBRICK #B-2890				SURFACE MOUNTED	B-275
B-290	5	X	PAPER TOWEL DISPENSER	BOBRICK #B-262				SURFACE MOUNTED	B-290
B-294	2	X	TRASH RECEPTACLE	BOBRICK #B-3644				SEMI-RECESSED	B-294
B-300	2	X	GRAB BAR 1-1/2"DIA X 36" S.S. FIN.	BOBRICK #B6806X36				SURFACE MOUNTED	B-300
B-305	2	X	GRAB BAR 1-1/2"DIA X 42" S.S. FIN.	BOBRICK #B6806X42				SURFACE MOUNTED	B-305
B-310	2	X	GRAB BAR 1-1/2"DIA X 18" S.S. FIN.	BOBRICK #B6806X18				SURFACE MTD	B-310
B-405	5	X	WASTE BASKET	RUBBERMAID SLIM JIM #3541 (GREY)					B-405
B-410	1	X	SANITARY NAPKIN RECEPTACLE	RUBBERMAID #6140				INCLUDES ACCESSORY KIT & MOUNTING HARDWARE	B-410
B-599	1	X	MOP SINK STATION	ISS #WST806Y					B-599
B-620	1	X	CHICKEN MOP SINK STATION	ISS #MOPCHICKMB					B-620
B-700	2	X	BABY CHANGING TABLE					G.C. TO CONFIRM RSCS PROVIDED ITEM CONFORMS TO REQUIRED CLEARANCES	B-700
-									
-									
			C COOKING EQUIPMENT						
C-001	3	X	COLLECTRAMATIC PRESSURE FRYER	WINSTON 64 LBS #LP46		X		POWERED BY 208 VOLTS 10,500 WATTS	C-001
C-018	4	X	OPEN FRYER W/ CONTROLLER	PITCO #KF-SFSSH75-2		X	X	COMES WITH GAS HOSE KIT	C-018
C-130	1	X	CONVECTION OVEN W/ CONTROLLER	BLODGETTE MARK V		X		6' POWER CORD, SLIDE OUT SHELF, 208 VAC 60HZ	C-130
C-183	2	X	MICROWAVE OVEN 2100 W	SHARP #R-25JTF		X			C-183
C-212	1	X	BUN TOASTER	PRINCE CASTLE # 297T9KFC		X			C-212
C-375	2	X	FRYER LANDING PORTABLE FRYER OIL FILTER	#CCF-16					C-375
-									
-									
-									
-									
-									
-									
			E EXHAUST HOODS/FIRE SUPP.						
E-241	1	X	2 - 10'-6" WIDE CANOPY HOOD	STRATOVENT		X		SEE HOOD MFR. DRAWINGS (HOOD 1 of 2) M3.0, M3.1	E-241
			F OFFICE/EMPLOYEE/MUSIC/MISC.						
F-006	1	X	FILE CABINET (2 DRAWER HIGH)	LOUISVILLE MILL - HON R512PL					F-006
F-024	1	X	CHAIR - OFFICE (MANAGER)	HON HLN7901AB10T					F-024
F-040	1		OFFICE COMPUTER	POS PROVIDED		X			F-040
F-050	1		CREDIT CARD SATELLITE ROUTER JUNCTION	YUM		X			F-050
F-060	1		MONITOR-OFFICE	YUM					F-060
F-080	1		OFFICE PRINTER/ COPIER/ FAX/ SCANNER	POS PROVIDED		X			F-080
F-090	1		UPS (UN-INTERUPTABLE POWER SUPPLY)	POS PROVIDED		X			F-090
F-131	1		MUSIC SYSTEM	MUZAK #6848. LOCAL LEASE		X		MUZAC (LOCAL LEASE), W/ 4 SPEAKERS	F-131
F-211	2	X	CLOCK	B&B SYSTEMS #02060475					F-211
F-270	1	X	FIRST AID KIT	SWIFT #68-UFPC					F-270
F-500	1	X	HIGH CHAIR	KOALA KARE #KB103 "CLASSIC" (GREY)					F-500
F-915	2	X	FLOOR MAT 3' x 5'	ENTRANCE, INC. #41150012				RUBBERIZED	F-915
F-920	1	X	FLOOR MAT 2' x 7'-6"	CREST #249614 ANTISLIP				RUBBERIZED	F-920
-									
-									
-									
-									
-									
-									
-									
-									
-									
-									
			K WORKSTATIONS/SHELVING/CARTS						
K-130	2	X	MOBILE FRONT COUNTER CART 18"X24"	ISS #FC18242MYA					K-130
K-131	1	X	MOBILE CONDIMENT CART	ISS #CONDDPSS					K-131
K-227	1	X	3 COMP. SINK WORKSTATION, 96"L	ISS #WST808E					K-227
K-269	1	X	BREADING WORKSTATION (DOUBLE) 18" x 48"	ISS #WST758Y					K-269
K-280	1	X	48" MICROWAVE WORKSTATION	ISS #WST760E					K-280
K-282	1	X	MIXER WORKSTATION	ISS #WST757E					K-282
K-300	7	X	DUNNAGE RACKS	YESS #PE84065					K-300
K-318	1	X	SLAW CART	TBD					K-318
K-425	2	X	BAKERS RACK 20.5" x 26" x 69"	NEW AGE INDUSTRIAL #1331					K-425
K-437	1	X	VEGGIE MODULE, 24" X 36"	ISS #WST 1139Y					K-437
K-498	1	X	SHELVING UNIT 18" x 48" x 74"H (4 TIER)	ISS #SU184874Y					K-498
K-502	3	X	SHELVING UNIT 24" X 36" X 74"H (4 TIER)	ISS #SU243674Y					K-502
K-504	1	X	SHELVING UNIT 24" X 48" X 74"H (4 TIER)	ISS #SU244874Y					K-502
K-506	7	X	SHELVING UNIT 24" x 60" x 74"H (4 TIER)	ISS #SU246074Y					K-506
K-512	4	X	SHELVING UNIT 18" x 60" x 74"H (4 TIER)	ISS #SU186074Y					K-512
K-660	1	X	SHELVING UNIT 24" x 36" x 74" (6 TIER)	SPG #KFC 24x36E					K-660
K-615	3	X	SHELVING UNIT 18" x 54" x 74"H (4 TIER)	ISS #SU185474Y					K-615
-									
-									
-									
-									
-									
			L LIGHTING/SIGNAGE/MENUBOARDS						
L-044	1	X	INTERIOR MAGNETIC MENU BOARD	POSTERLOID # PSTR7PANELHWDKIT				INCLUDES MOUNTING RAILS AND BRACKETS.	L-044
L-150	1	X	SECURITY DOOR DANGER SIGN	ADVERCO#ADVCUSTOM				ORDERED DIRECT FROM YRFS	L-150
L-151	1	X	CHAMPS BOARD 31"W x 23"H					ORDERED DIRECT FROM YRFS	L-151
-									

EQUIPMENT SCHEDULE

NO.	QTY	G.C. INST.	ITEM DESCRIPTION	MFR & MODEL NUMBER	PLUMB	ELECT	GAS	REMARKS	NO.
3			**N SINKS/DISHWASHERS**						
N-014	1	X	3-COMP POWER SOAK 108"L x 34"D	METCRAFT #200PSB108L121DIPKFC	X	X		W/ T & S B-2466 FAUCET & SPRAY RINSE	N-014
N-053	3	X	HAND SINK (KITCHEN)	AERO #HS-MOD	X				N-053
N-071	1	X	MOP SINK FAUCET	T&S #B-2465	X				N-071
N-131	1	X	PRE-RINSE KIT	T&S B-2466	X			FOR N-014	N-131
N-133	3	X	HAND SINK FAUCET	T&S FAUCET B-2456-W	X			SPLASH MOUNTED, FOR N-053	N-133
N-150	3	X	HAND SINK FOOT PEDAL	T&S B-0507	X			FOR N-053	N-150
N-202	1	X	MOP SINK 24" x 24" FLOOR MOUNT SINK	AERO MANUFACTURING CO., INC. #3MP-2121-6	X			INCLUDES (2) 24"X36" WALL PANELS	N-202
			P FOOD PREPARATION						
P-063	1	X	WARMER, FRY, CRISP N HOLD	#CNH28LP208V/ 60HZ		X			P-063
P-101	1	X	FRANKE BUCKET TOWER						P-101
P-189	1	X	DUAL ELECTRICAL OUTLETS	DELFIELD		X		DELFIELD DUAL M-LINE	P-189
P-190	1	X	HOT WELL TABLE	DELFIELD		X		DELFIELD DUAL M-LINE	P-190
P-191	1	X	COLD WELL TABLE	DELFIELD		X		DELFIELD DUAL M-LINE	P-191
P-192	1	X	AMBIENT WELL, DUAL	DELFIELD				DELFIELD DUAL M-LINE	P-192
P-193	1	X	BASE UNIT 25"	DELFIELD				DELFIELD DUAL M-LINE	P-193
P-194	1	X	BASE UNIT 35"	DELFIELD				DELFIELD DUAL M-LINE	P-194
P-195	1	X	FRY DUMP TABLE	DELFIELD				DELFIELD DUAL M-LINE	P-071
P-532	1	X	SHORTENING SHUTTLE	WORCESTER SS-709					P-532
P-575	1	X	CAN OPENER	EDLUND EDL16100					P-575
P-601	2	X	BREADING TABLE (SINGLE), 48"L x 30"W x 36"H	AYRKING #BBS-U-4830-BPC		X			P-601
P-651	1	X	CONVECTION OVEN TABLE, 32"W x 31"D x 24"H w/ 4"H RAILS	APW #4857720				ON CASTERS	P-651
P-652	1	X	WORK TABLE over 1/2-HEIGHT FREEZER, 32"W x 31"D x 36"H	APW #4857800					P-652
P-674	1	X	WORK STATION FOR HOT WATER 18"W x 30"D x 76"H	ISS #WST790E				HOT WATER DISPENSER STATION	P-674
P-721	2	X	5 GAL HOT WATER MACHINE	BUNN 125000066	X	X			P-721
-									
			R REFRIGERATION						
R-030	2	X	1/2 HT. FREEZER (RH) STD. CASTERS	DELFIELD 407CA, RH		X			R-030
R-930	1	X	PACKLINE EQUIPMENT	TBD					R-0930
R-931	1	X	PACKLINE EQUIPMENT	TBD					R-931
			S SERVING/DRIVE-THRU						
S-015	2	X	HOLDING CABINET	AHC993RH	X	X		L/H FRONT, R/H BACK w/ FLIP DOORS BOTH SIDES	S-015
S-017	1	X	IMPROVED FULL-HEIGHT HEATED CABINET	HENNY PENNY #AHC-990LSD		X		L/H FRONT, R/H BACK w/ GLASS DOOR BOTH SIDES	S-017
S-028	1	X	GRILL TABLE	SLTG4821-K					S-028
S-044	1	X	BUN HOLDING CABINET	KFCEVOBH208		X		FLIP DOOR ACCESS ON BOTH SIDES	S-044
S-053	1	X	HOLDING CABINET	KFCEVOSH208		X		SLIDING DOOR ACCESS ON BOTH SIDES	S-053
S-087	1	X	INFARED HOLDING BIN	PRINCE CASTLE DHB2PT33KFCB		X			S-087
S-200	1		DRIVE-THRU TIMER	HME		X			S-200
S-250	1		DUAL OUTPUT VEHICLE DETECTOR	HME		X			S-250
S-251	1		DRIVE-THRU TIMER DISPLAY UNIT	HME		X			S-251
S-260	1	X	DRIVE THRU CONDIMENT TOWER	ISS #CONDTOW24L					S-260
S-283	1	X	DRIVE THRU DRINK STAGER	ISS #WST788E					S-283
S-287	1		WATER FILTER SYSTEM	SELECTO #BFCS, PART #66-6145LFM	X			PROVIDED and INSTALLED BY PEPSI	S-287
S-288	1	X	WATER FILTER SYSTEM	SELECTO #SMFIC614, PART #80-6140	X			PROVIDED BY OWNER / INSTALLED BY G.C.	S-288
S-346	1	X	PICK-UP DRIVE-THRU COUNTER (30" x 54")	ISS #WST1140Y					S-346
S-361	1	X	BEVERAGE COUNTER-DRIVE THRU 53"L x 32"D x 34"H	ISS#WST1140Y					S-361
S-404	1	X	BUNN TB 3-Q BREWER						S-404
S-413	2	X	URN						S-413
S-449	1	X	TIME TAG SYSTEM	FRANKE #27800400					S-449
S-453	2	X	T-SHIRT BAG HOLDER	FRANKE #27012973				ATTACH TO POSTPACK <P-107>	S-453
S-482	1	X	CUP DISPENSER 30-1/16" x 15-1/16" x 23-3/4"D	A.J. ANTUNES #DACS60					S-482
S-483	1	X	CUP DISPENSER 22" W x 19" H x 5 5/8" D	DIVERSIFIED METAL #WR-CC-22-RD					S-483
S-504	1	X	LID AND STRAW DISPENSER	DISPENSE-RITE #DMP TLD-3BT-2STR					S-504
S-514	2		ICE CUBER	MANITOWOC # 1Y0684C	X	X			S-514
S-532	2		BEVERAGE DISPENSER (SELF SERVE / DRIVE THRU)	CORNELIUS #ED 250	X	X			S-532
S-550	1		BAG-N-BOX SYRUP RACK	CORNELIUS/REMCOR BNB12B8P	X			FLO-3REG-2CRB, PROVIDED and INSTALLED BY PEPSI	S-550
S-570	2		CARBONATOR	CORNELIUS/REMCOR	X	X		LOCATED ON SHELF BENEATH DRINK MACHINE	S-570
S-580	1		CO2 (BULK) TANK	MVE #11805373				WITHOUT IMPURITY RING	S-580
S-600	2		BUNDLED SYRUP LINES	CORNELIUS/REMCOR TUBE BUNDLE	X			PROVIDED and INSTALLED BY PEPSI	S-600
S-x01	3	X	NAPKIN TOWER	EXPRESSNAP 32XSP				DRINK, FRONT COUNTER, DT	S-818
			U SECURITY/COMM./FIRE PROT./POS						
U-008	1	X	BASE STATION - D/T COMM. SYSTEM w/ HEADSET RACK	ION IQ 6A10 SYSTEM; HME #C30000-6-HS-YUM		X		6 COMMUNICATORS & BATTERY CHARGER, +7'-0" A.F.F.	U-008
U-012	1	X	INTEGRATED PACKLINE KIT	ICP105					U-012
U-013	1	X	VIEWSONIC LCD DISPLAY	VA705B		X			U-013
U-031	1	X	CCTV DVR & MONITOR	MARTCO, INC. #E58050046		X			U-031
U-050	1	X	SECURITY SYSTEM	ADT #E53200155		X			U-050
U-070	3		RECEIPT PRINTER	POS PROVIDED		X		2 FOR F/C AND 1 D/T	U-070
U-100	4		POS/ORDER ENTRY TERMINAL	POS PROVIDED		X			U-100
U-120	2		CASH DRAWER HOLDER	POS PROVIDED				SEE SCOPE OF WORK	U-120
U-152	3		CASH DRAWER	POS PROVIDED				SEE SCOPE OF WORK	U-152
U-197	2	X	MONITOR WALL BRACKET	POS PROVIDED					U-197
U-198	6	X	17" MONITOR (FLAT SCREEN)	POS PROVIDED		X		SEE SCOPE OF WORK	U-198
U-250	6		BUMP BAR	POS PROVIDED					U-250
-									
			W WALK-IN COOLERS/FREEZERS						
W-212	1	X	WALK-IN COOLER / FREEZER	SEE DISTRIBUTOR EQUIPMENT MODEL	X	X			W-212

NOTE: ITEMS NOTED AS "CURRENTLY UNDER A FIELD VALIDATION PROGRAM" ARE PART OF A LARGE SCALE EVALUATION AND MAY NOT BE APPROVED FOR CONITNUING USE FOLLOWING COMPLETION OF THE EVALUATION. PLEASE CONTACT YOUR DISTRIBUTOR IF YOU HAVE ANY QUESTIONS.

B. D/T CLEARANCE BAR, SECURITY DOOR, WATER HEATER, D/T WINDOW, RESTROOM ACCESSORIES, AIR DOOR/CURTAIN, MOP SINK, HAND SINK ACC., CORNER GUARDS, MATS
C. FRYERS, OVENS, GRILLS, RETHERMALIZERS, TOASTERS, MICROWAVES
E. KITCHEN EXHAUST HOODS, FIRE SUPPRESSION EQUIPMENT
F. SAFE, OFFICE EQUIPMENT, EMPLOYEE STORAGE/BREAK
K. SHELVING, WORKSTATIONS, CARTS, RACKS, DOLLIES
L. SITE LIGHTING, SIGNAGE, MENUBOARDS
N. POWERSOAK, KITCHEN HAND SINKS, PREP. SINKS, DISHWASHERS
P. M.A.P.S. LINES, I-LINES, PACK LINES, BREADERS, MARINATORS, HOT WATER, WORK TABLES, CHEESE MELTERS
R. REFRIGERATORS AND FREEZERS (NOT WALK-IN)
S. DRINK SYSTEMS & EQUIP., HEAT CABINETS, STAGERS, WARMERS, SERVING EQUIP., D/T EQUIP.
U. SECURITY SYSTEM, LOCKS, CCTV, D/T COMMUNICATIONS/POS SYSTEM, POS EQUIP.
W. WALK-IN COOLERS/FREEZERS

LIS ARCHITECTURE ENGINEERING
LAND INVESTMENT SERVICES, LLC
AA 26002040 CA NO: 6853 LB1057
ARCHITECTURE / ENGINEERING OFFICE
Phone: (321) 244-0402
facsimile: (321) 244-9419
ENGINEERING OFFICE
214,30 Palms Beach Blvd.
Ave., Fla. 33920
Phone: (239) 693-9244
facsimile: (239) 693-9828
HAROLD DANIEL HUTTER III
FL. REG. AR98913

PLAN SET REVISIONS:
1 06/22/22 - BUILDING COMMENTS

CONTRACT DATE: 12-18-2019
BUILDING TYPE: Kb 30-19
PLAN VERSION:
SITE NUMBER:
ENTITY NUMBER:
STORE NUMBER:
LIS PROJECT; 2019-303

KFC
OAKLEAF CORNER OUTPARCEL 3
DUVAL COUNTY, FL

Kb 30-19

EQUIPMENT SCHEDULE

A2.1

PLOT DATE: 03/29/2022